

Name

Service No. 1738

Address 21 Wilson RD

Location

Kind of Pipe 6 PVC

Size 6"

Size of Main

Repair—Renewal—New Service T.D. J. McLaughlin

Location


| Date | Material | Amount | Total | Date | Amount |
|---------|--------------------|--------|-------|------|--------|
| 4/28/05 | 6 4" Sch 40 PVC | | | | |
| 48' | 6" PVC | | | | |
| 1 | 4x6 Fernco | | | | |
| 1 | 6" ACX PVC Fernco | | | | |
| | EXIST A.C. Pipe | | | | |

DATE _____

TOWN OF LEXINGTON — BOARD OF PUBLIC WORKS

SEWER DIVISION

Sketch of Service Here

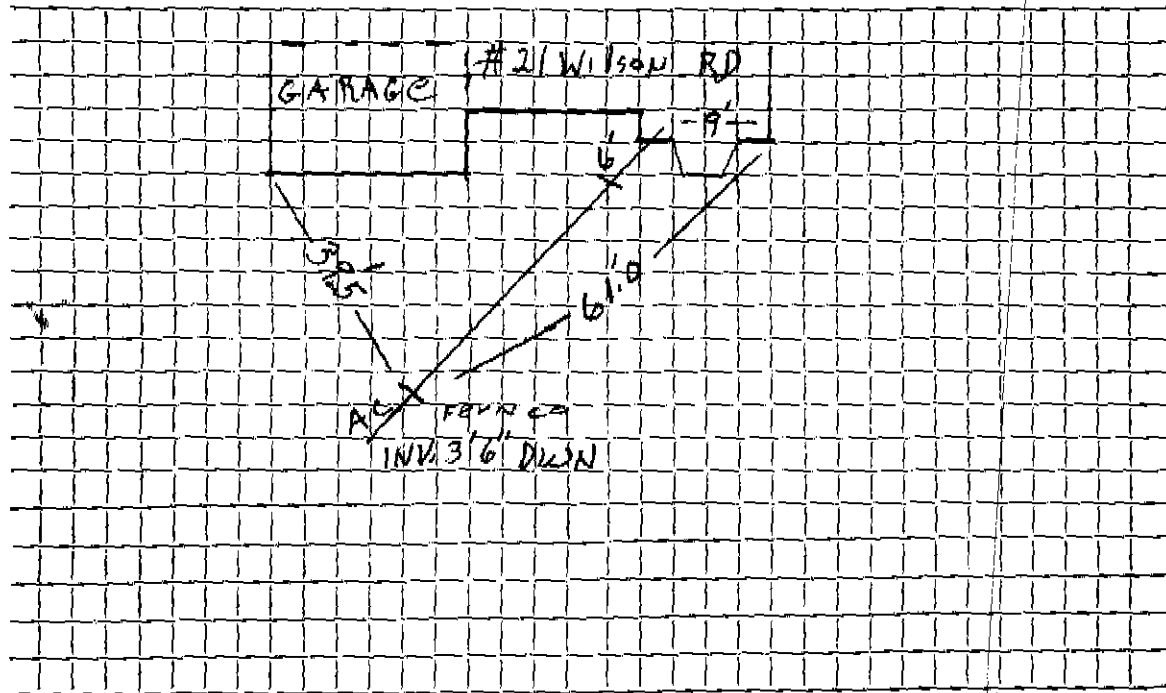

Connection made in Street. Work completed 4/28/05 J. McLaughlin

Remarks:

.....

.....