

Name Albert E. Gilman

Service No. 230

Address 23 Wilson Rd.

23 Wilson Road

Location

Kind of Pipe

Size 6"

Size of Main 8"

~~Repair~~ New Service

Location *Com. 12-21-59*


Date	Material	Amount	Total	Date	Amount
	20' 6" Transite pipe @3.50			11-19-59	150.00
	installed by cont.		70.00	12-31-59	1.51
11-19-59	Labor	38.40			148.49
	10% O.H.	3.84	42.24		
	30' 6" Transite pipe @.70		21.00		
	2 hrs. Town Shovel @6.50		13.00		
	3 hrs. Trucking @.75		2.25		
			148.49		

DATE _____

TOWN OF LEXINGTON — BOARD OF PUBLIC WORKS
SEWER DIVISION

Sketch of Service Here

23

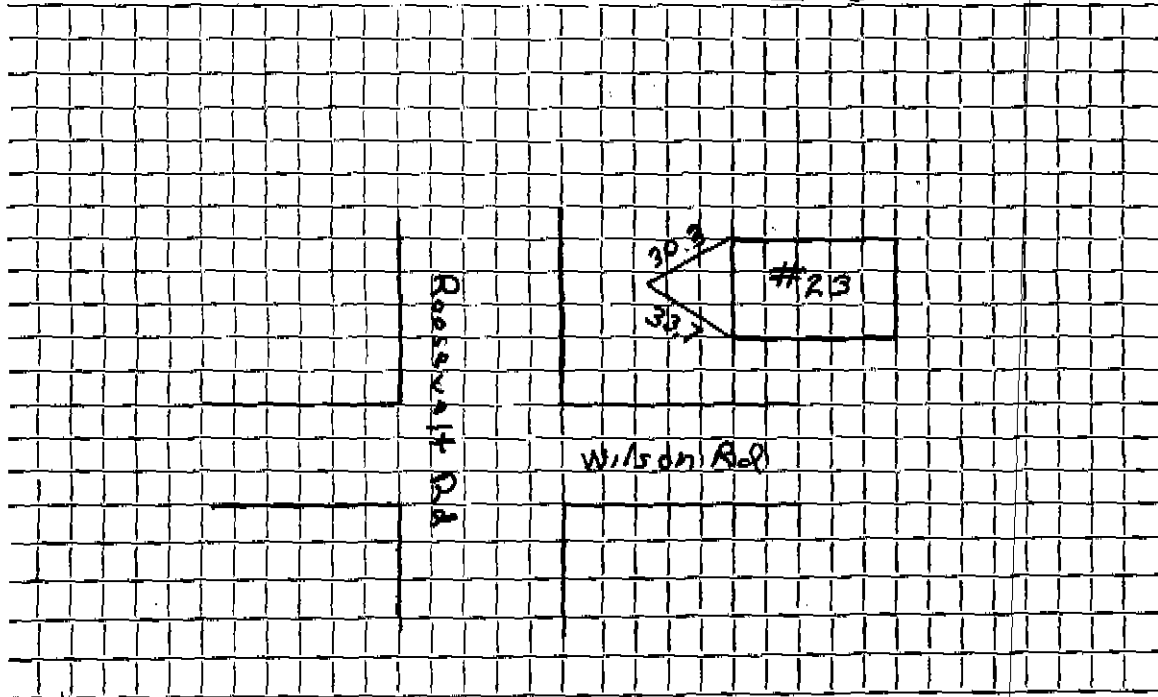

Connection made in Roosevelt Rd. ~~Street~~ Work completed

Remarks:

.....