

Name Charles Murphy

Service No. 231

Address 24 Wilson Rd

24 Wilson Road

Location

Kind of Pipe

Size 6"

Size of Main 8"

XXXXXX New Service

Location *Nov 12-31-59*

Date	Material	Amount	Total	Date	Amount
	20' 6" Transite pipe @3.50			11-18-59	Deposit 200.00
	installed by cont.		70.00	2-9-60	Paid 1.53
11-17-59	Labor	67.20			201.53
	10% O.H.	6.72	73.92		
	50' 6" Transite pipe @.70		35.00		
	1 6" Transite Adapter		1.90		
	1 22 $\frac{1}{2}$ ^o Transite Bend		6.21		
	2 hrs. Town Shovel @6.50		13.00		
	2 hrs. Trucking @.75		1.50		
			201.53		


Bill 500

DATE _____

TOWN OF LEXINGTON — BOARD OF PUBLIC WORKS

SEWER DIVISION

Sketch of Service Here **24**

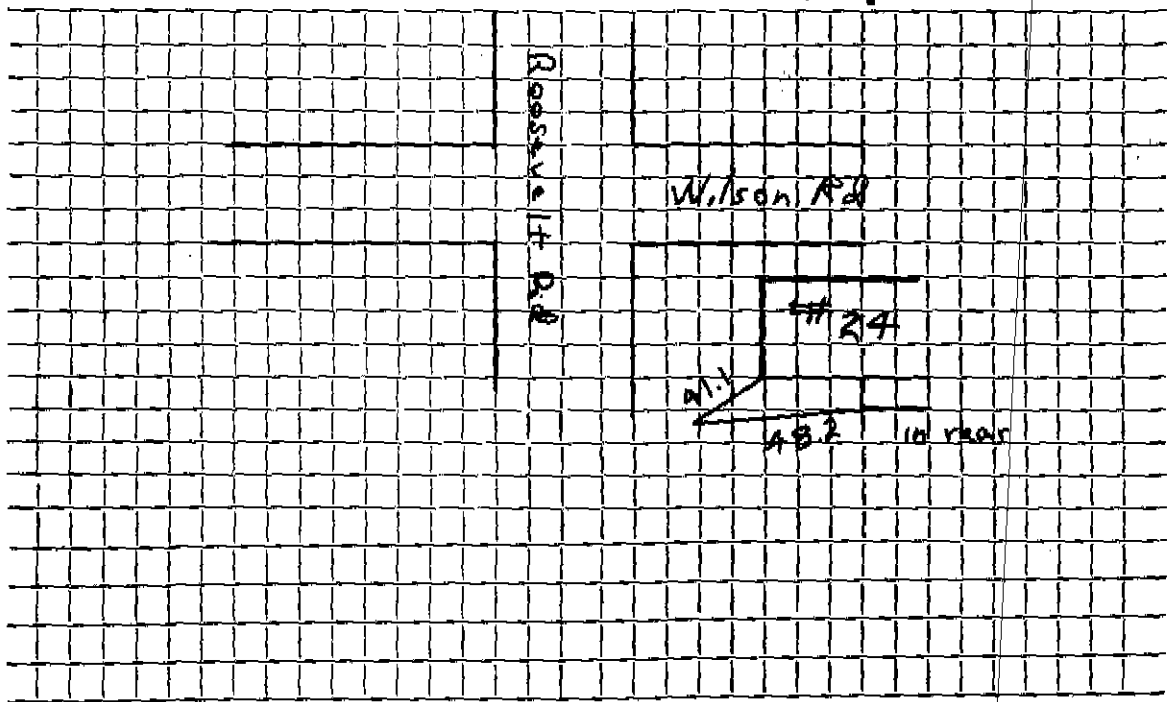

Connection made in Roosevelt Rd. ~~Street~~ Work completed

Remarks: