

Name Edward D'Entremont

Service No. 117

Address 29 Wilson Rd

29 Wilson Road

Location

Kind of Pipe

Size 6"

Size of Main 8"

~~XXXXXXXXXX~~ New Service Wc # 9427


Location Comm 10-29-62

Date	Material	Amount	Total	Date	Amount
	20' 6" Transite pipe @3.50			7-30-62	Deposit 200 00
	installed by cont.		70 00	10-29-62	Refund 23 39
8-28-62	Labor 46.92				126 61
8-23-62	" 17.82	64.74			
	10% O.H.	6.47	71.21		
	20' 6" Transite pipe @3.20		16.40		
	2 Hrs. Town Shovel @6.50		13.00		
	2 Hrs. Trucking @3.00		6.00		
			176.61		

DATE \_\_\_\_\_

**TOWN OF LEXINGTON — BOARD OF PUBLIC WORKS**  
**SEWER DIVISION**

Sketch of Service Here **29**

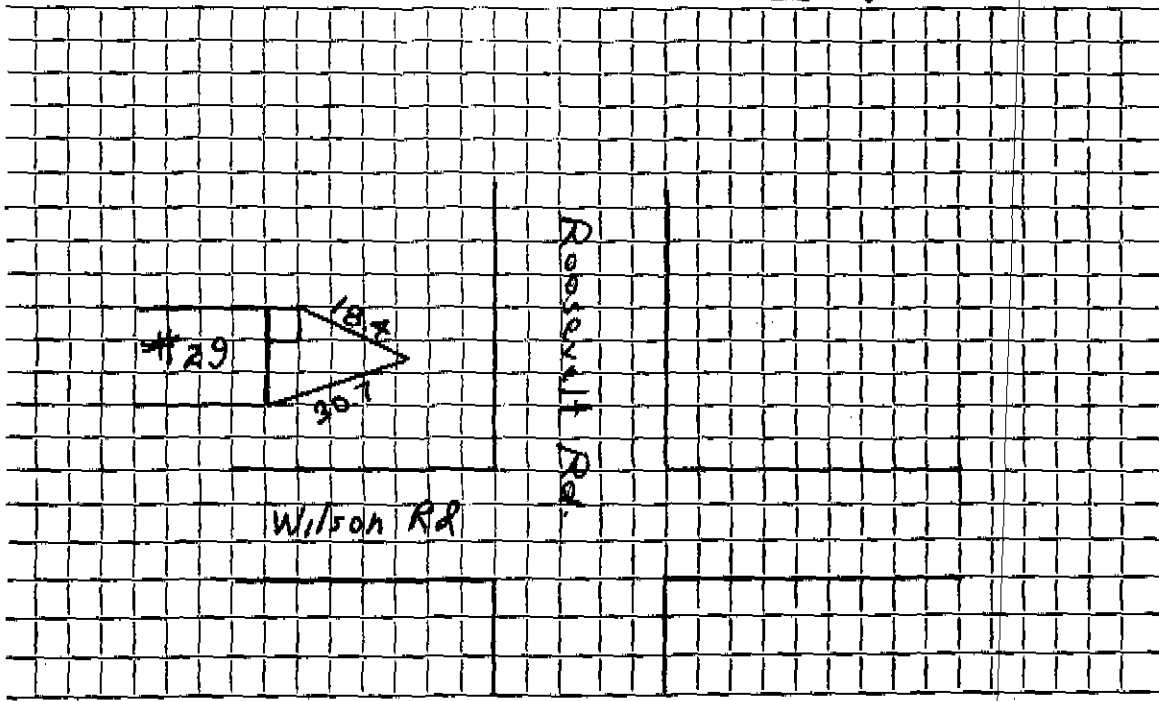

Connection made in Roosevelt Rd Street. Work completed .....

Remarks: .....

.....