

Name Gustav Pinkell

Service No. 137

Address 30 Wilson Rd

30 Wilson Road

Location

Kind of Pipe

Size 6"

Size of Main 8"

~~XXXXXX~~ New Service


Location Cam 11-16-59

Date	Material	Amount	Total	Date	Amount
	30' 6" Transite pipe @3.50			8-17-59	Deposit 20.00
	installed by cont.		105.00	12-16-59	Paid 23.85
9-2-59	Labor	49.91			223.85
	10% O.H.	4.99	54.90		
	48' 6" Transite pipe @.70		33.60		
	1 20" Cesspool Cover & Frame		10.50		
	50 Sewer Brick @4.20 per 100		2.10		
	1 bag Cement @1.50		1.50		
	1 ton Brick sand @1.00		1.00		
	2 hrs. Town Shovel @6.50		13.00		
	3 hrs. Trucking @.75		2.25		
			223.85		

DATE \_\_\_\_\_

TOWN OF LEXINGTON — BOARD OF PUBLIC WORKS  
SEWER DIVISION

Sketch of Service Here **30**

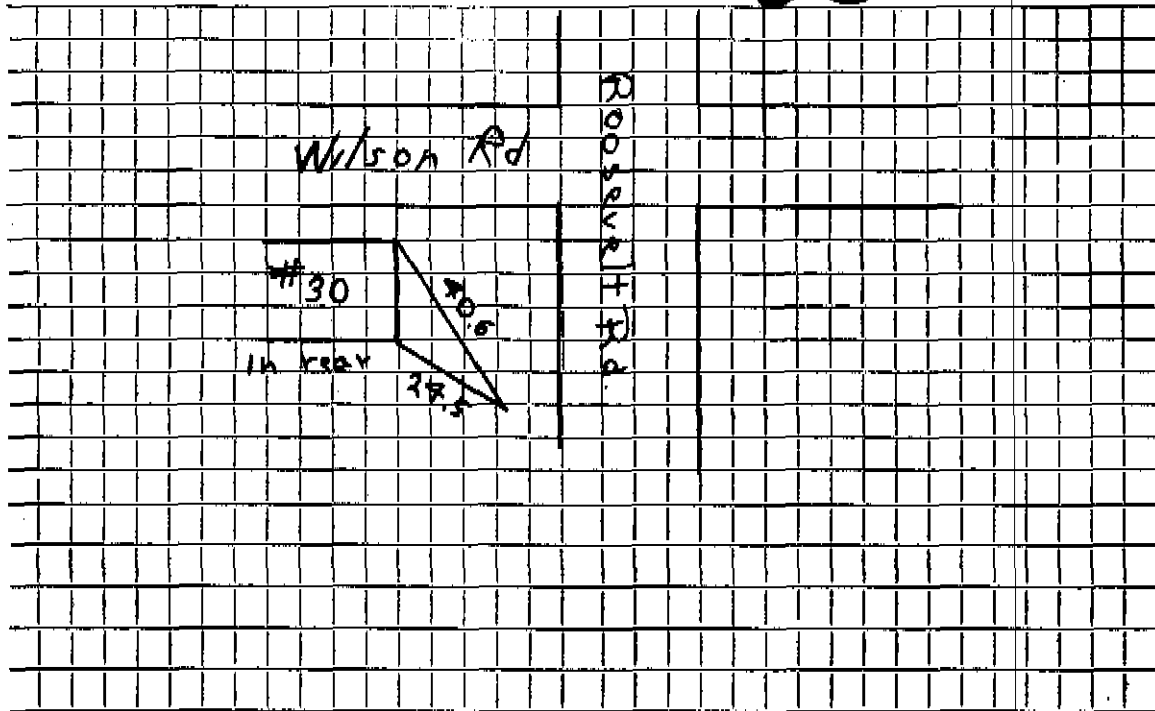

Connection made in Roosevelt Rd Street. Work completed .....

Remarks: .....