

Name

Service No.

Address

4 Wilson Rd

Location

Kind of Pipe

Size

Size of Main

Repair—Renewal—New Service

Location

Date

Material

Amount

Total

Date

Amount

9-19-03

Inside

6'-4" PVC

35'-6" PVC

6x4 PVC to PVC flange


6x6 PVC to AC flange

6" 45° Bend

DATE _____

TOWN OF LEXINGTON — BOARD OF PUBLIC WORKS
SEWER DIVISION

Sketch of Service Here

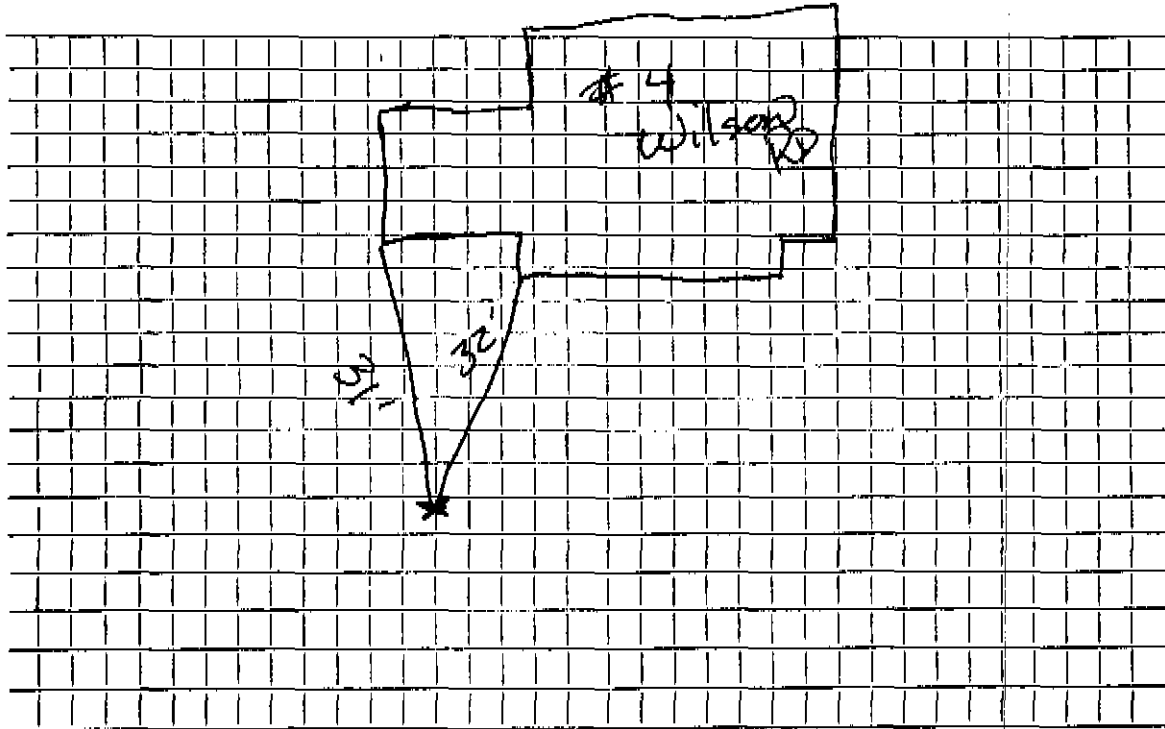

Connection made in Street Work completed

Remarks: SERVICE COMES OUT ONTO
..... ROOSEVELT RD
.....