

Name

Service No.

Address

9 Wilson Rd

Location

Kind of Pipe

Size

Size of Main

Repair Renewal New Service

Location

Date

Material

Amount

Total

Date

Amount

6-18-01

SERVICE RENEWED

10' - 4" PVC

4" x 6" PVC to PVC FERRICO

1 - 6" 45° Bend


52' - 6" PVC

1 - 6x6 PVC to AC FERRICO

DATE _____

TOWN OF LEXINGTON — BOARD OF PUBLIC WORKS
SEWER DIVISION

Sketch of Service Here

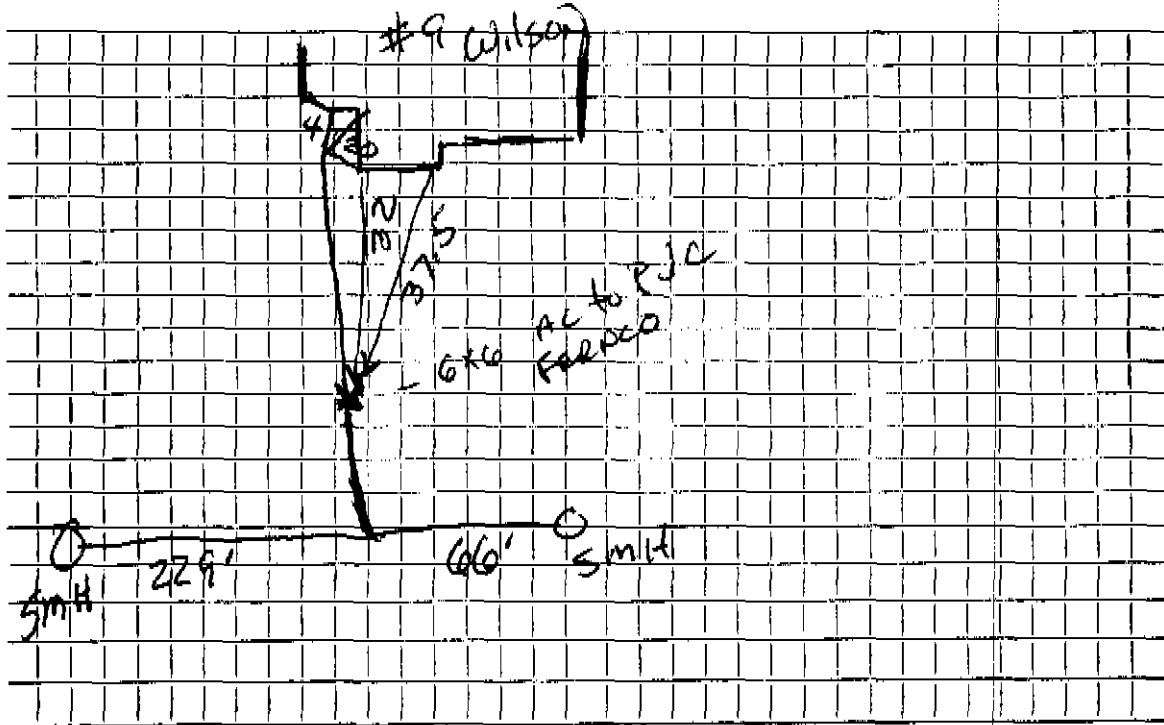

Connection made in Street. Work completed

Remarks: Old house been down