

Name

Service No.

Address 12 WIMCHESTER DR

Location

Kind of Pipe

Size

Size of Main

Repair—Renewal—New Service


Locations

Date	Material	Amount	Total	Date	Amount
4/24/66	RENEW	SAWTS			
	43' 6" PVC				
	1 GKL FENRUCO				
	CLEAN OUT 9' FOR HOUSE				
	7' DEEP				
	CLAY OUTSIDE				

DATE 04/24/00

TOWN OF LEXINGTON — BOARD OF PUBLIC WORKS  
SEWER DIVISION

Sketch of Service Here

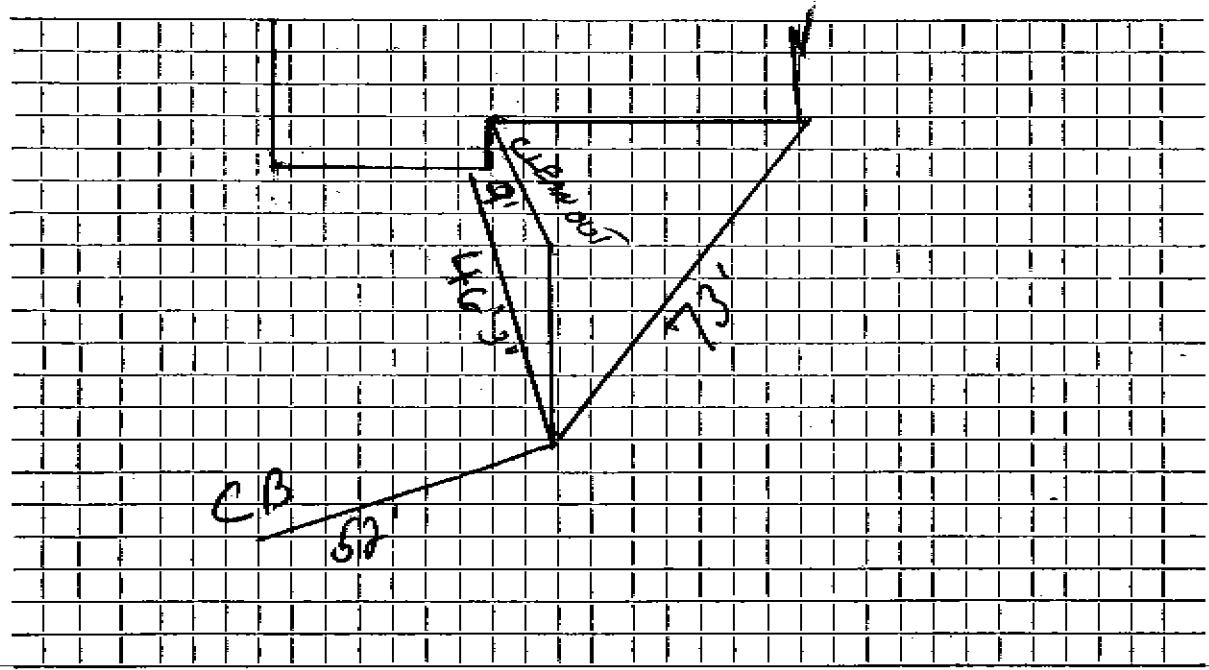

Connection made in ..... Street. Work completed .....

Remarks: .....  
.....  
.....