


DATE 03/01/24

TOWN OF LEXINGTON — BOARD OF PUBLIC WORKS

SEWER DIVISION

Sketch of Service Here
16 WINCHESTER DR.

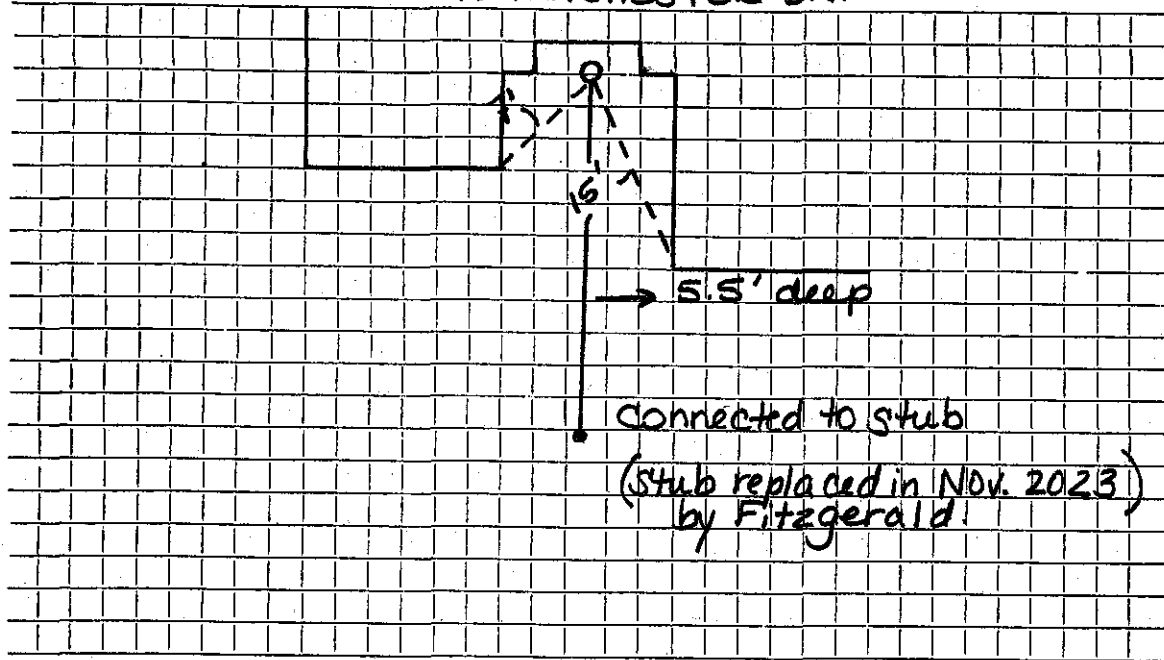

Connection made in Street. Work completed

Remarks: Installed by Uticon

