

Name DeVries Const. Co.

Service No. _____

Address 25 Winchester Drive

Location _____

Kind of Pipe _____

Size _____

Size of Main _____

Repair—Renewal—New Service _____

Installed by Developer

Location _____

Date

Material

Amount

Total

Date

Amount

10/21/55

Labor

**TOWN OF LEXINGTON—DEPT. OF PUBLIC WORKS
SEWER DIVISION**

DATE.....

NO.


The undersigned applies for the construction of a particular sewer connecting No.....
Street and hereby agrees to comply with the Rules and Regulations governing the construction and use of Particular
Sewers, as now or at any future time established by the Board of Selectmen.

Am't of estimate \$.....

Am't Paid \$.....

..... Owner

Sketch of Service Here

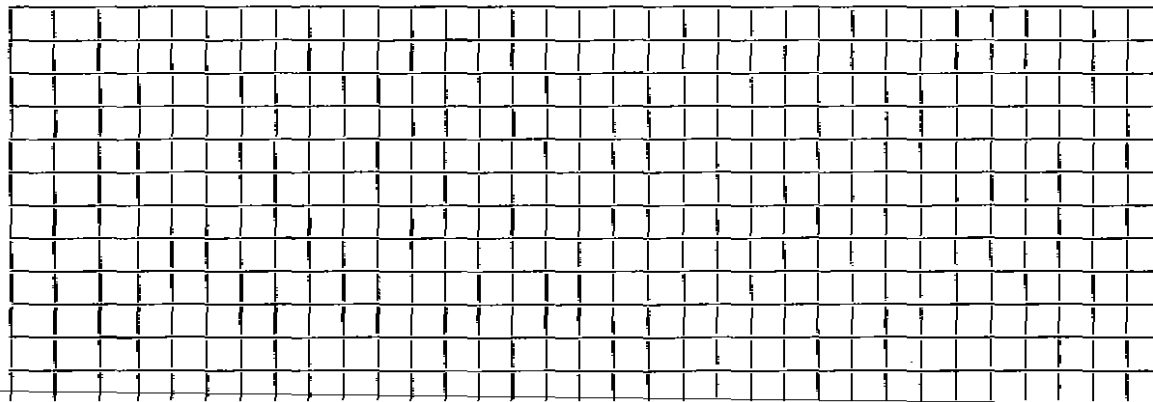

Connection made in Street.

Work completed.....19..

Remarks: