

Name DeVries Const. Co.

Service No.

Address 28 Winchester Drive

Location

Kind of Pipe

Size

Size of Main

Repair—Renewal—New Service

Installed By Developer

Location

Date	Material	Amount	Total		Date			Amount
10/20/55								
	Labor							

**TOWN OF LEXINGTON—DEPT. OF PUBLIC WORKS**  
**SEWER DIVISION**

DATE.....

NO. ....

The undersigned applies for the construction of a particular sewer connecting No.....  
Street and hereby agrees to comply with the Rules and Regulations governing the construction and use of Particular  
Sewers, as now or at any future time established by the Board of Selectmen.


Am't of estimate \$. ....

Am't Paid \$. ....

..... Owner

---

**Sketch of Service Here**

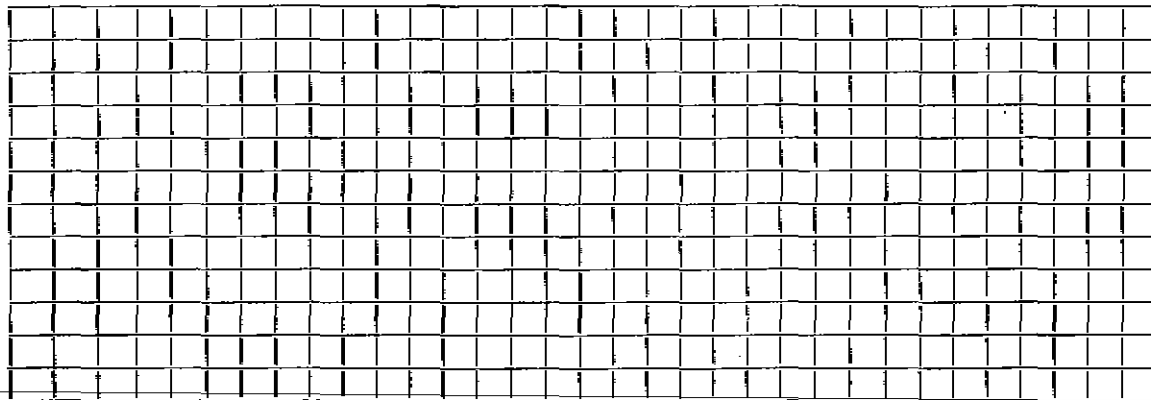

Connection made in ..... Street. Work completed. .... 19..

Remarks: