


DATE _____

TOWN OF LEXINGTON — BOARD OF PUBLIC WORKS
SEWER DIVISION

Sketch of Service Here

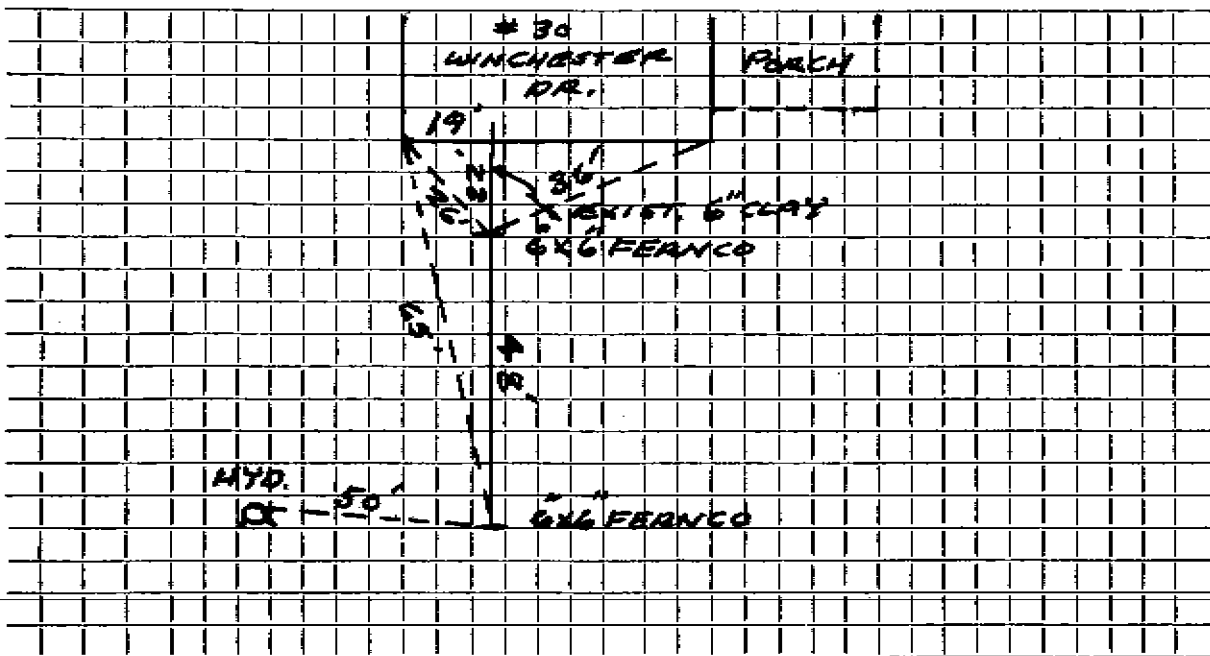

Connection made in WINCHESTER DRIVE Street. Work completed

Remarks: RE-NEWAL