

Name DeVries Const. Co.

Service No.

Address 31 Winchester Drive

Location

Kind of Pipe

Size

Size of Main

Repair—Renewal—New Service

Installed by Developer

Location

Date

Material

Amount

Total

Date

Amount

10/21/55

7-18-02 main Blocked
147+100' from M.H.

3-24-08 Service Blocked
on Property, Needs To
Be Re-newed.

Labor

TOWN OF LEXINGTON—DEPT. OF PUBLIC WORKS
SEWER DIVISION

DATE.....

NO.


The undersigned applies for the construction of a particular sewer connecting No.....
Street and hereby agrees to comply with the Rules and Regulations governing the construction and use of Particular
Sewers, as now or at any future time established by the Board of Selectmen.

Am't of estimate \$.....

Am't Paid \$.....

..... Owner

Sketch of Service Here

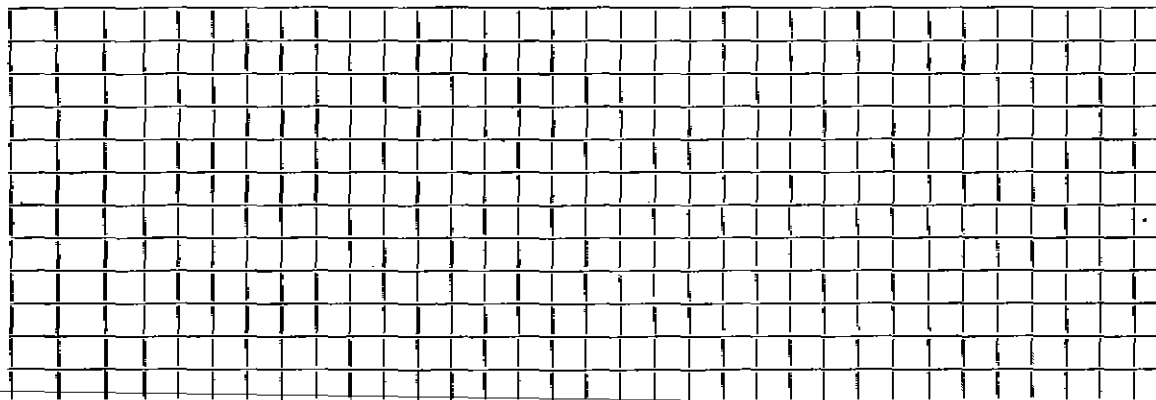

Connection made in..... Street.

Work completed.....19..

Remarks: