

Name **DeVries Const. Co.**

Service No.

Address **35 Winchester Drive**

Location

Kind of Pipe

Size

Size of Main

Repair—Renewal—New Service

Installed by Developer

Location

Date	Material	Amount	Total	Date	Amount
1/21/55					
	REPAIR-NON CHARGE				
11-16-62	Labor 41.96				
11-19-62	" 31.47	73.43			
	10% O.H.	7.34	80.77	9/28/87 29'	OUTSIDE 6" PVC Pipe
	2 hrs. Town Shovel @6.50		13.00	1	33° 6" Sweep
	2 hrs. Trucking @.75		1.50	2	6" Fernco PVC to Clay
			95.27		
	Labor				

TOWN OF LEXINGTON—DEPT. OF PUBLIC WORKS

SEWER DIVISION

DATE.....

NO.


The undersigned applies for the construction of a particular sewer connecting No.....
 Street and hereby agrees to comply with the Rules and Regulations governing the construction and use of Particular
 Sewers, as now or at any future time established by the Board of Selectmen.

Am't of estimate \$.....

Am't Paid \$.....

..... Owner

Sketch of Service Here

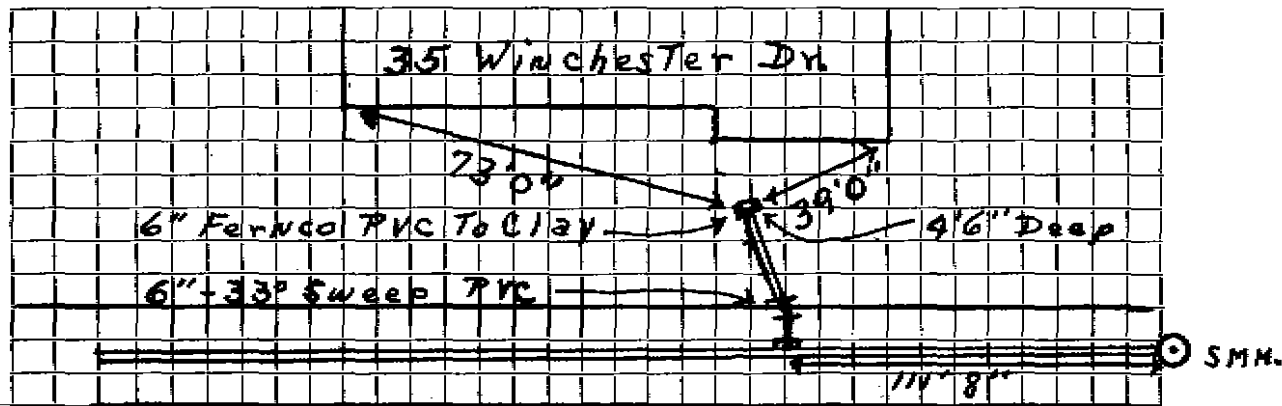

Connection made in..... Street.

Work completed.....19..

Remarks: