
Date: 2/21/24

TOWN OF LEXINGTON - BOARD OF PUBLIC WORKS SEWER DIVISION

SKETCH OF SERVICE HERE

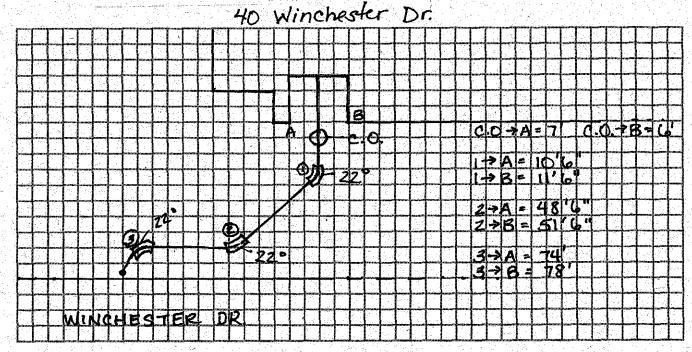

Connection made in:

Street.

Work completed:

Remarks: Installed by TBR Excavating

Sewer Service Record

Name		Service No.						
Address 40 V	Ninchester Dr	•		·	<u></u>			
			Location					
Kind of Pipe 5D	R 35 PVC		Size 6"			8"		
Repair - Renewal					Location			
Date	Material	Amount	Total	Date		Amount		

Date	Material	Amount	Total	Date		Amount
2/21/24	6" 5 DR 35 PVC	·				
	6" Cleanout	<u>.</u>			<u> </u>	
			·	<u> </u>		
			·			
				<u> </u>		
) 				
						_
]				