

Name

Contractor:

Service No.

Address

8 Winding Rd

Location

Kind of Pipe

SDR35 PVC + SDR21 Size 6" & 2"

Size of Main

Repair—Renewal—New Service

Location

Date

Material

Amount

Total

Date

Amount

4/4/19

6" Cleanout

6" PVC

6" 22' band

6" PVC

6" 22' band

6" PVC


New SMH

2" SDR 21

DATE 4/4/2019

TOWN OF LEXINGTON — BOARD OF PUBLIC WORKS
SEWER DIVISION

Sketch of Service Here

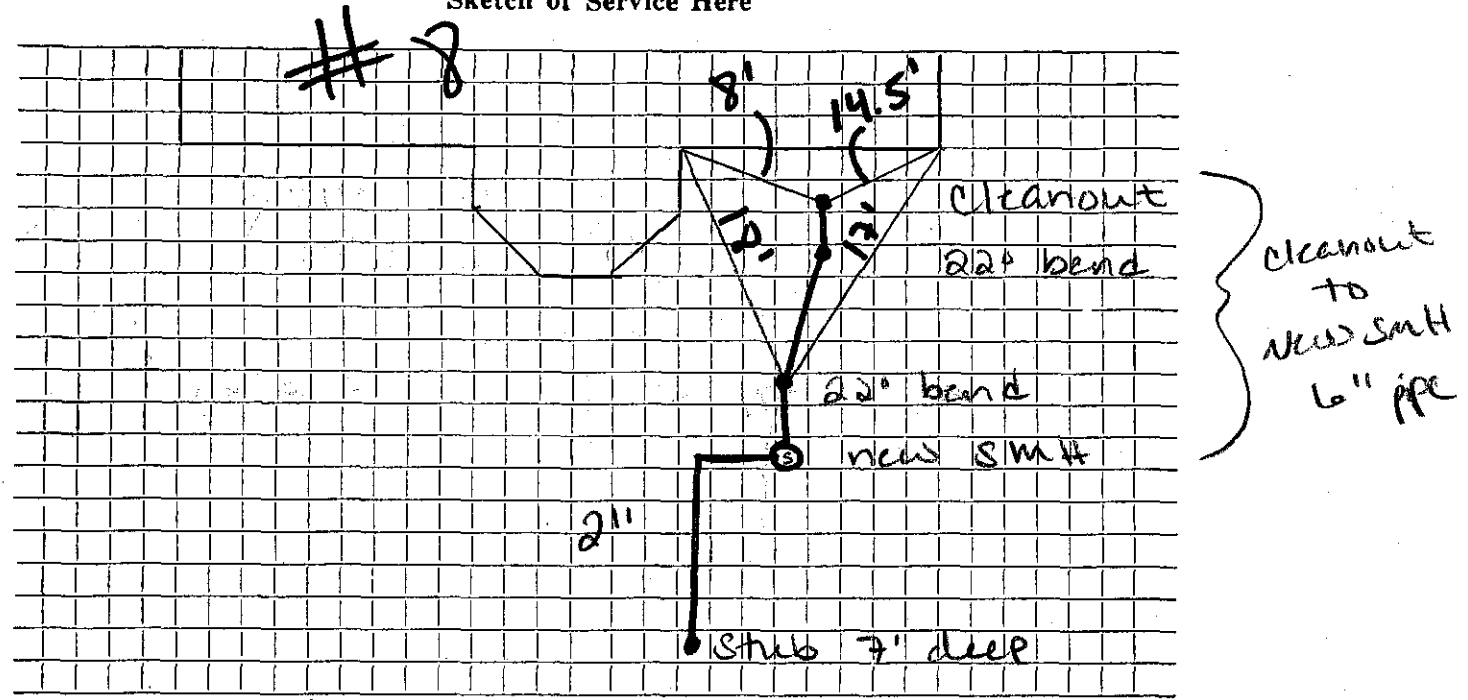

Connection made in Winding Rd Street. Work completed

Remarks: Part of subdivision's pump

Lot # 9?