

TOWN OF LEXINGTON — BOARD OF PUBLIC WORKS

12-10-12

SEWER DIVISION

12-10-12

12-10-12


12-10-12

12-10-12

Sketch of Service Here

12

12-10-12

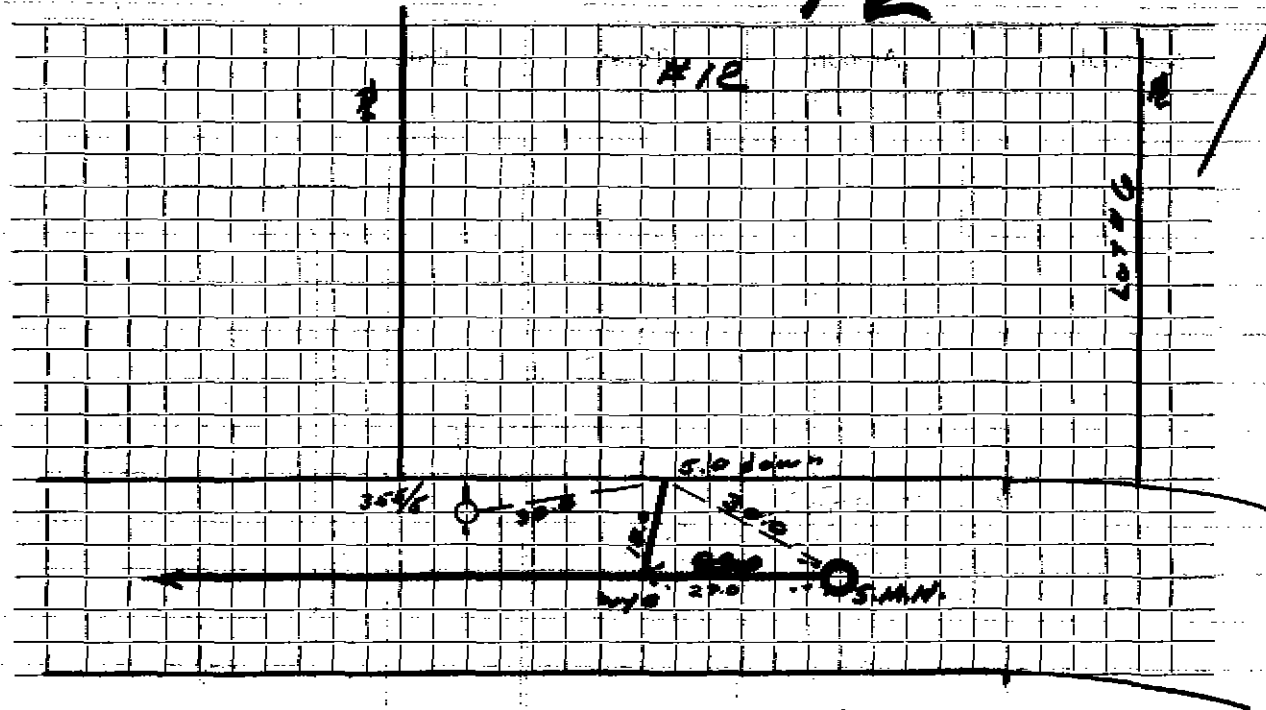

Connection made in Street. Work completed

Remarks:
.....
.....