

Name A. J. Comeau

Service No. 129

Address 3 Wingate Road, Lexington

Map I: Old Coach Rd., Weston, Mass.

Location

Kind of Pipe

Size 6"

Size of Main 8"

~~Service Renewal~~ New Service service installed to curb by developer Location *Com. 11-21-55*

Date	Material	Amount	Total	Date	Amount
9/17/55	Labor	11 20		6-27-55	Deposited 200 00
	10% Overhead	1 12	12 32	11-21-55	Refunded 171 53
	37'-6" Sewer Pipe @.32		11 84		28 47
	1-1/8" Bend		1 28		
	Joint Compound		2 28		
	1 hr. trucking @.75		75		
			28 47		
12/4/74	23' 6" A.C. PIPE @ 9.00		\$207.00		
	THIS IS A NEW ADDITIONAL SERVICE.				
	Labor				
HP-6411					

TOWN OF LEXINGTON—DEPT. OF PUBLIC WORKS

SEWER DIVISION

DATE

NO.


The undersigned applies for the construction of a particular sewer connecting No. Street and hereby agrees to comply with the Rules and Regulations governing the construction and use of Particular Sewers, as now or at any future time established by the Board of Selectmen.

Am't of estimate \$.....

Am't Paid \$.....

..... Owner

Sketch of Service Here **3**

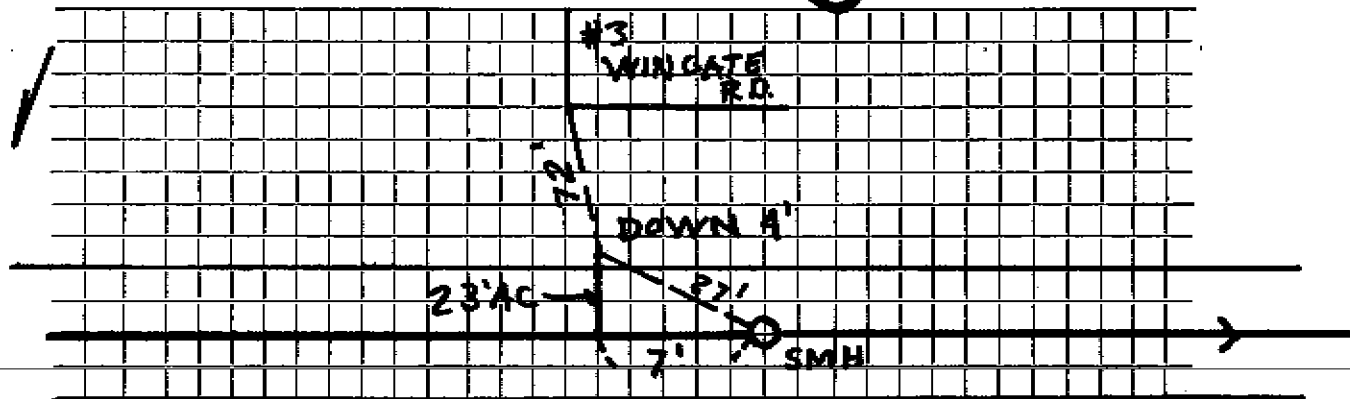

Connection made in Street.

Work completed 19..

Remarks: