

Name

Service No.

Address

4 Wingate Rd

Location

Kind of Pipe

Size

Size of Main

Repair—Renewal—New Service

Location

Date

Material

Amount

Total

Date

Amount

6-10-02

4X6 PVC to PVC Fittings
6" 220 Bend

6X6 PVC to AC Fittings

10' 4" PVC


50' - 6" PVC

12-9-74

23' - 6" AC

DATE _____

TOWN OF LEXINGTON — BOARD OF PUBLIC WORKS
SEWER DIVISION

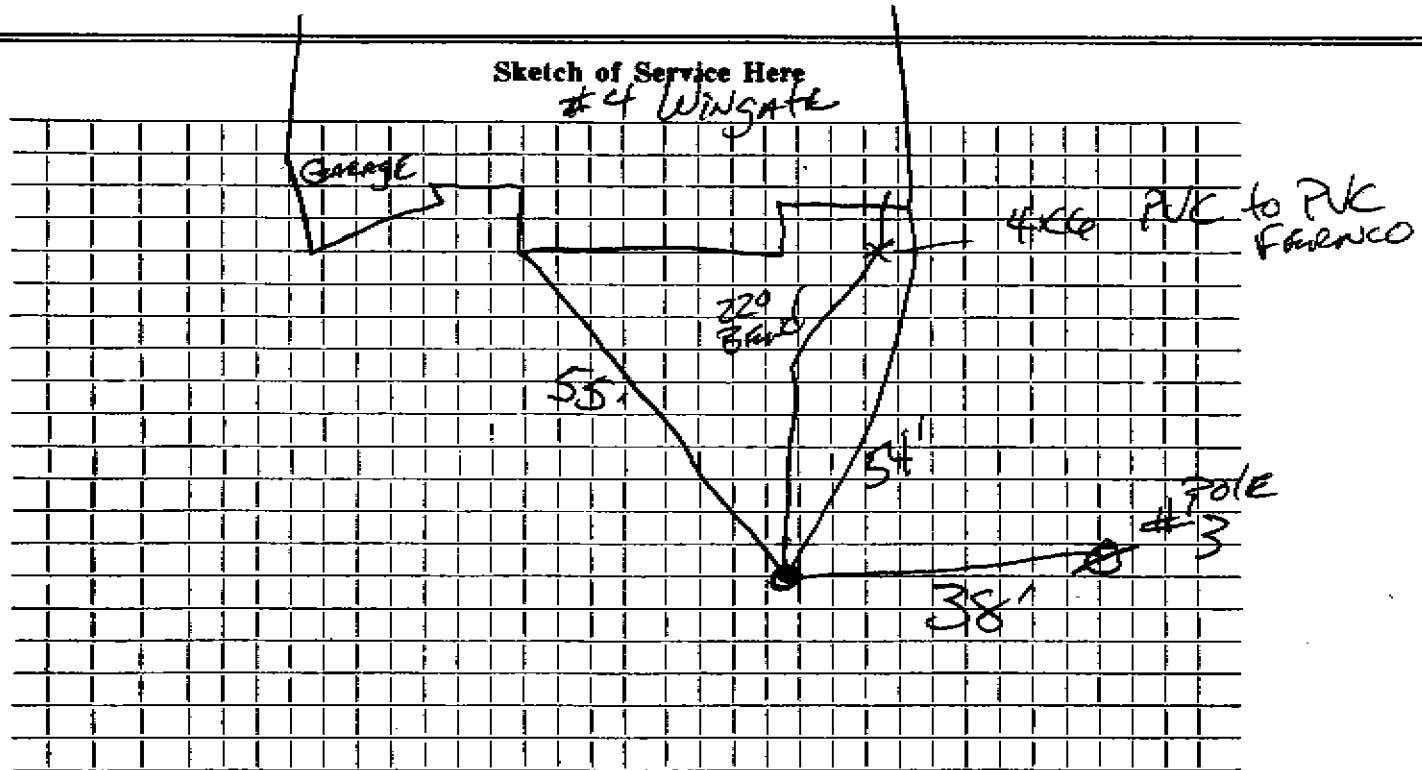

Connection made in Street. Work completed

Remarks:

.....

.....