


DATE 9/12/90

TOWN OF LEXINGTON — BOARD OF PUBLIC WORKS
SEWER DIVISION

Sketch of Service Here **6**

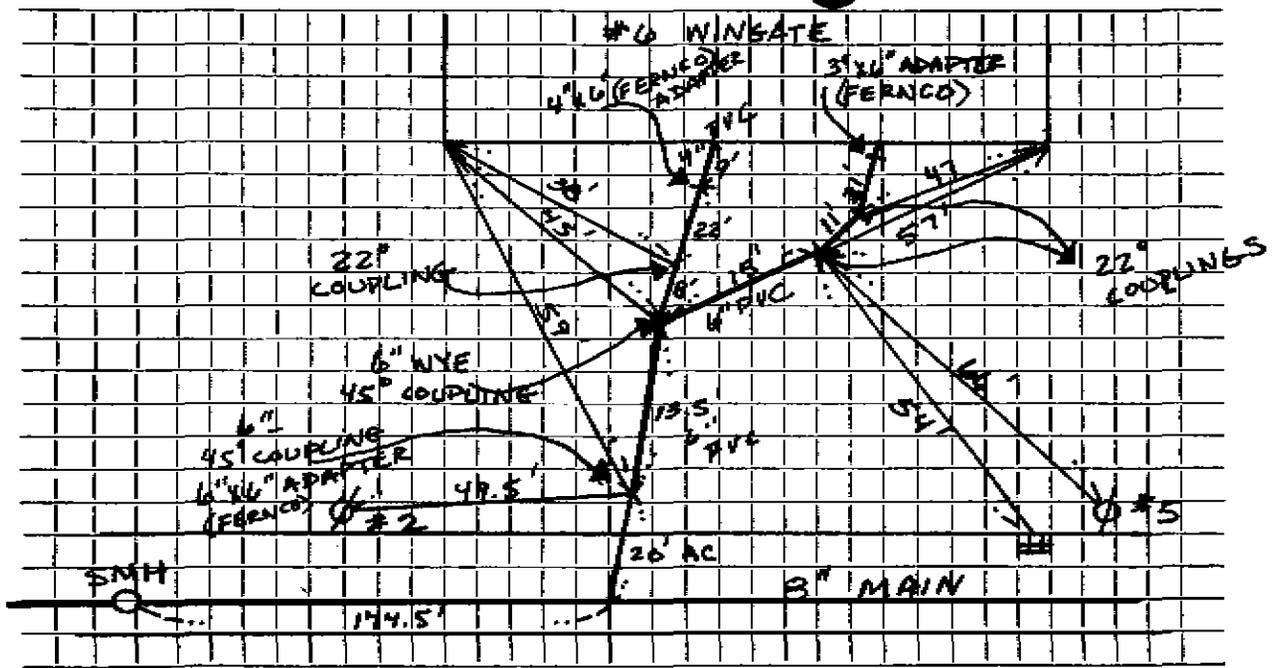

Connection made in WINGATE Street. Work completed

Remarks: CONTRACTOR: KIRKLAND & SHAN

INSPECTED: P. BARRONS