

Name

Service No. 1856

Address 9 Wingate RD

Location

Kind of Pipe PVC

Size 6

Size of Main 8" A.C.

Repair—Renewal—New Service Tardouano J McLaughlin

Location


Date	Material	Amount	Total	Date	Amount
8/27/05	6' 4" PVC S.L. 40				
	38' 6" PVC.				
	1 4X6 FENCE				
	1 6" A.S.XPVC FENCE				
	1 6"-22° bend				
	EXISTING IN ST.				
9/12/12	1/6" A.C. PIPE				
	8X6 W/lye				

DATE \_\_\_\_\_

TOWN OF LEXINGTON — BOARD OF PUBLIC WORKS

SEWER DIVISION

Sketch of Service Here

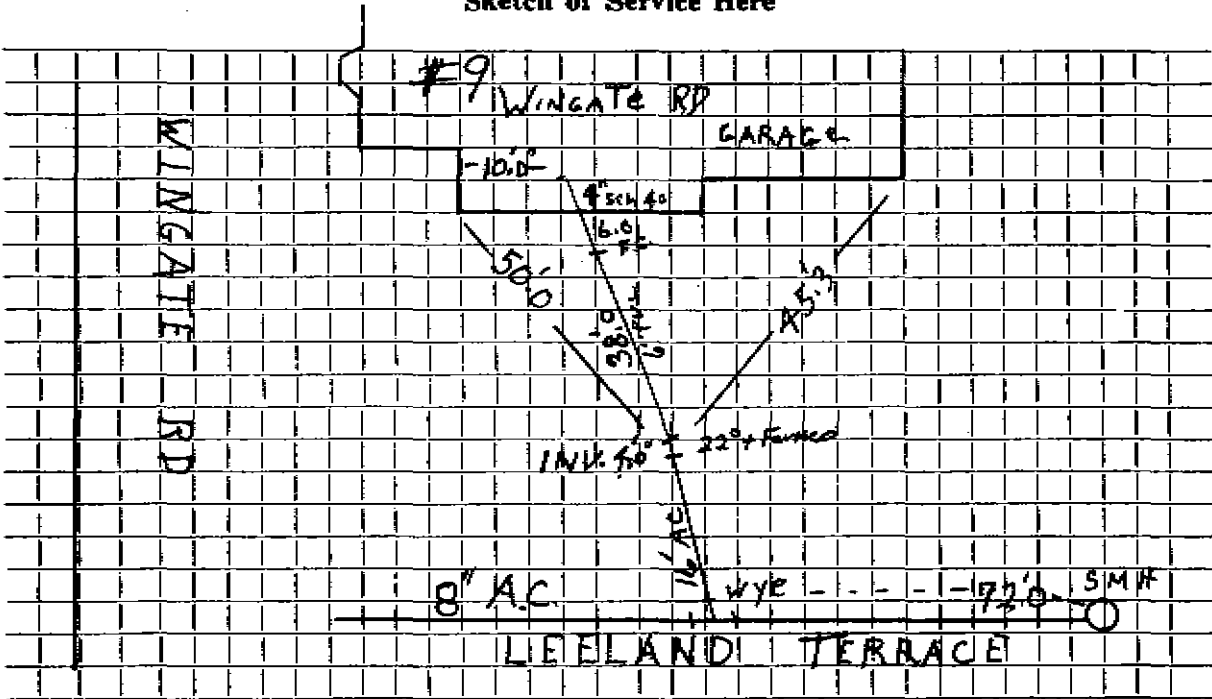

Connection made in ..... Street.

Work completed 8/27/05 J McLaughlin

Remarks: .....  
.....  
.....