



DATE 12-5-90


TOWN OF LEXINGTON — BOARD OF PUBLIC WORKS

SEWER DIVISION

#4 WINSTON Rd.

Sketch of Service Here

4

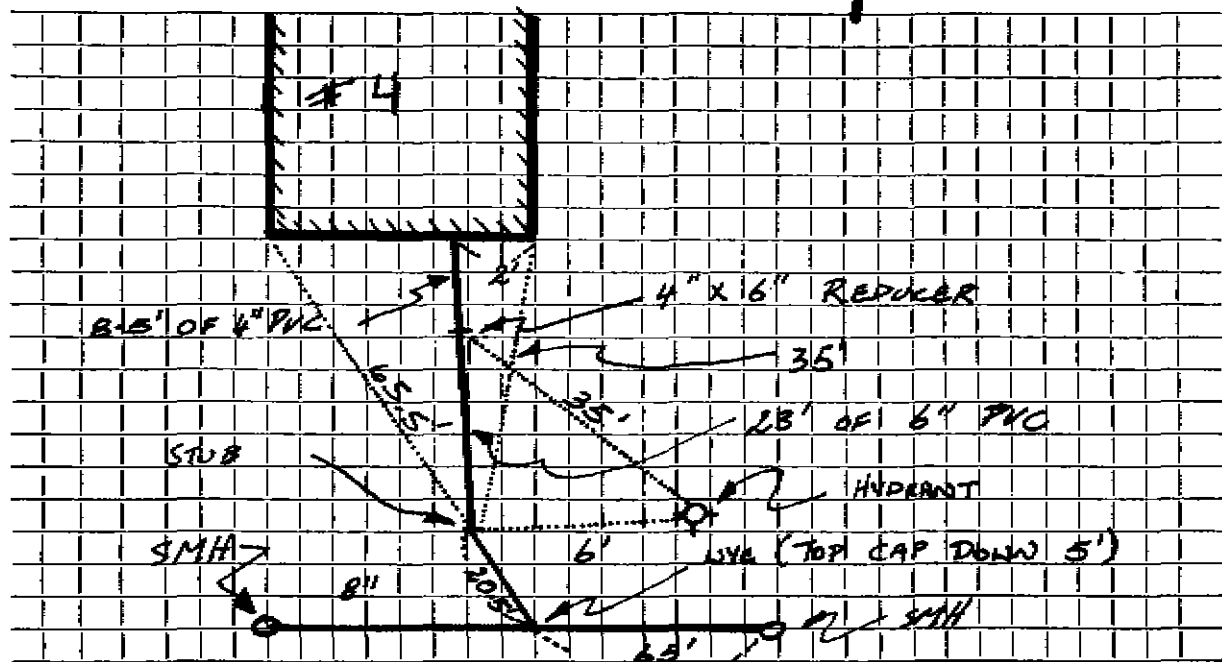

Connection made in ... WINSTON ROAD ... ~~SEWER~~ Work completed ... 12-5-90 ...

Remarks: INSPECTED ... 12-5-90 ... BY P. BARRONS ; INSTALLED BY E.R. BANKS ...