




# TOWN OF LEXINGTON — BOARD OF PUBLIC WORKS

## SEWER DIVISION

Sketch of Service Here **8**

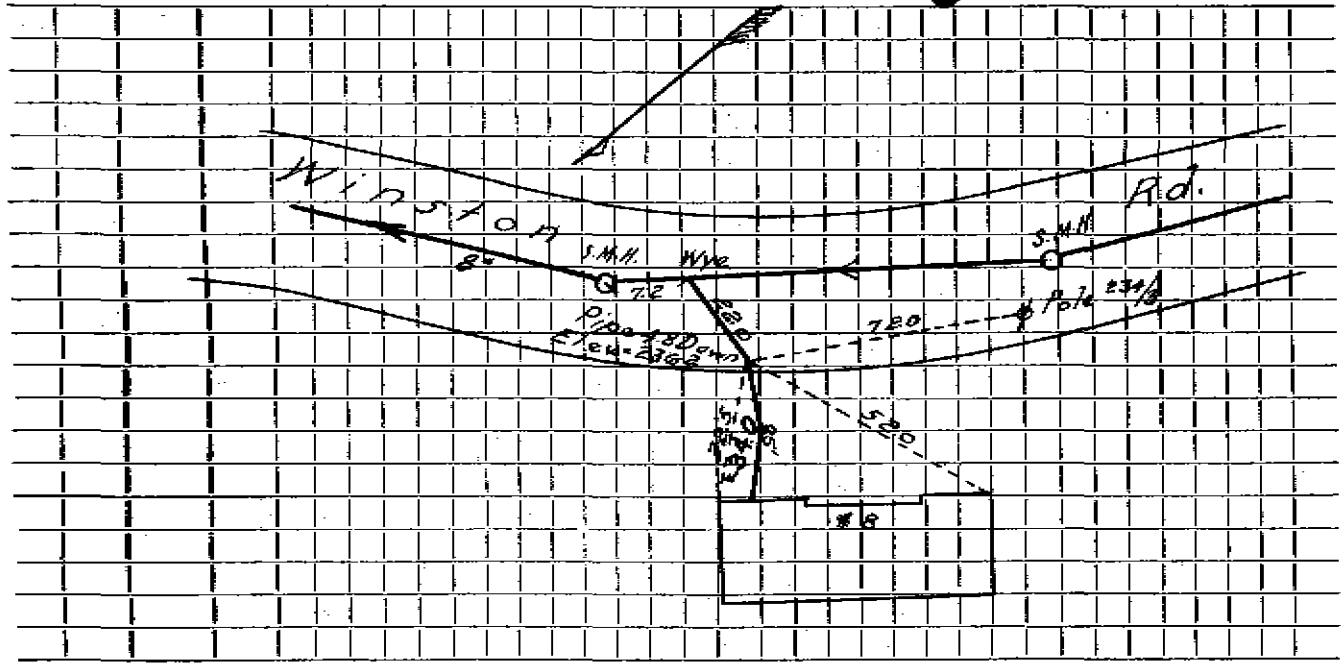

Connection made in ..... Street. Work completed .....

Remarks :  
.....  
.....  
.....