

Name **Raymond Wilhelm**Service No. **161**Address **10 WINTER ST.****10 Winter Street**

Location

Kind of Pipe

Size **6"**Size of Main **8"**~~Replacement~~ **New Service**Location **Comm 12-8-58**

Date	Material	Amount	Total	Date	Amount
10/7/58	Labor	20 50		9-24-58	200 00
10/8/58	Lab or	15 38		12-8-58	87 74
		<u>35 88</u>			
	10% Overhead	3 59	39 47		<u>112 26</u>
	50'-6" Transite Pipe @ .70		35 00		
	1-6"-90 Transite Elbow		5 29		
	2 hrs. Town Shovel @ 6.50		13 00		
	1 hr. Trucking @ 3.00		3 00		
	1 hr. Rodgers Trailer @ 3.00		3 00		
	2 hrs. Trucking @.75		1 50		
	12 x 3 Patch		<u>12 00</u>		
			112 26		
	Labor				

TOWN OF LEXINGTON—DEPT. OF PUBLIC WORKS

SEWER DIVISION

DATE.....

NO.


The undersigned applies for the construction of a particular sewer connecting No..... Street and hereby agrees to comply with the Rules and Regulations governing the construction and use of Particular Sewers, as now or at any future time established by the Board of Selectmen.

Am't of estimate \$.....

Am't Paid \$.....

..... Owner

Sketch of Service Here **10**

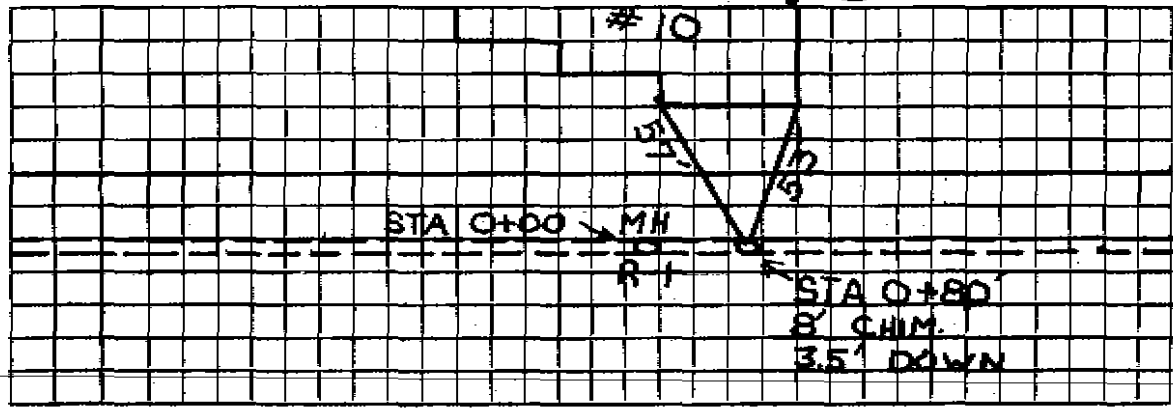

Connection made in..... Street.

Work completed.....19..

Remarks: