

Name **Mohammad Shimali**

Service No. **10**

Address **\*100 Winter Street**

Lot. **#52 & 53**

Location **Lots 52 & 53**

Kind of Pipe

Size

Size of Main

Repair—Renewal—New Service **Sibley #1820**

Location **JUL 26 1971**

Date		Material	Amount	Total	Date	Amount
10-1-69	25'	6" Transite pipe @9.00		225.00	3-26-71	Deposit 225.00
4-13-71	30'	6" Transite pipe				
	10'	4" Cast Iron pipe				

we will respond to a sewer blockage - Free and measure the blockage and note in report  
 11/1/82  
 DS


DATE \_\_\_\_\_

TOWN OF LEXINGTON — BOARD OF PUBLIC WORKS

SEWER DIVISION

Sketch of Service Here

100

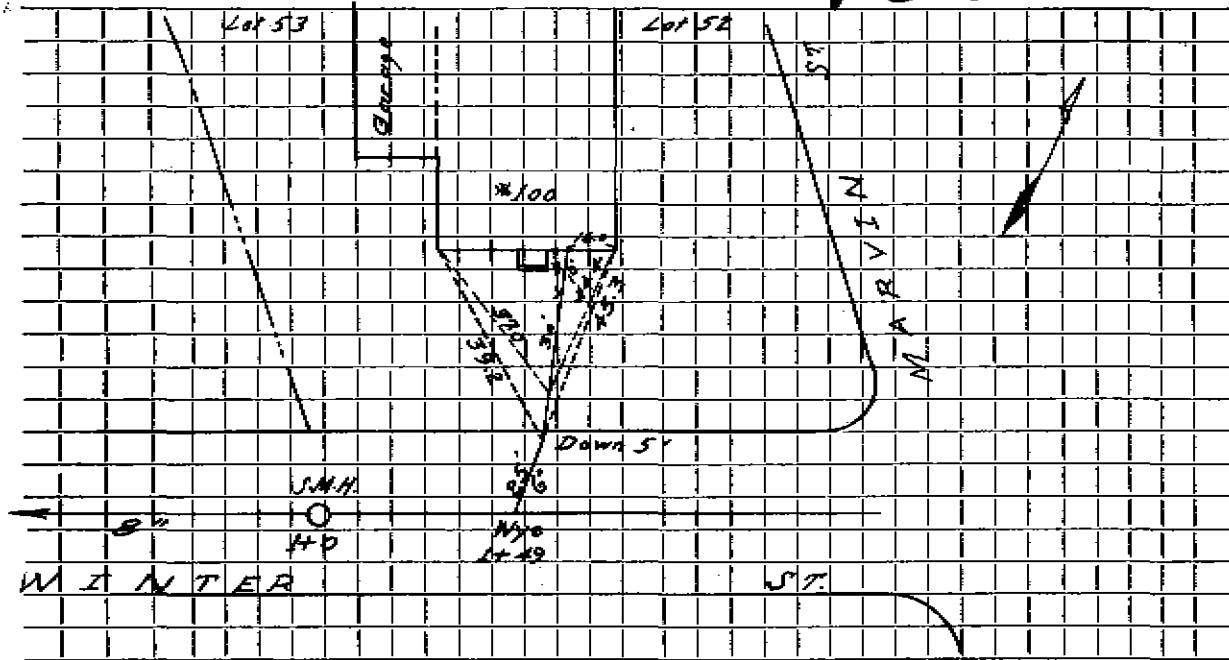

Connection made in ..... Street. Work completed .....

Remarks: .....

.....

.....