

Name JOHN PAGE Realty Trust

Service No. 49

Address 101 WINTER STREET
(VACANT LOT #14)

Location

Kind of Pipe

Size

Size of Main

~~Repair~~ ~~Renewal~~ New Service DATE 8/16/73 # 3343

Location S.E. PT. 25 1779

Date	Material	Amount	Total	Date	Amount
9-18-78	6" TRANSFER PIPE	9.00	288.00	9-31-78	DEPOSIT 288.00
9-25-78	50' 6" MCP				

11-88

S&S Paper


DATE _____

TOWN OF LEXINGTON — BOARD OF PUBLIC WORKS

SEWER DIVISION

Sketch of Service Here

101

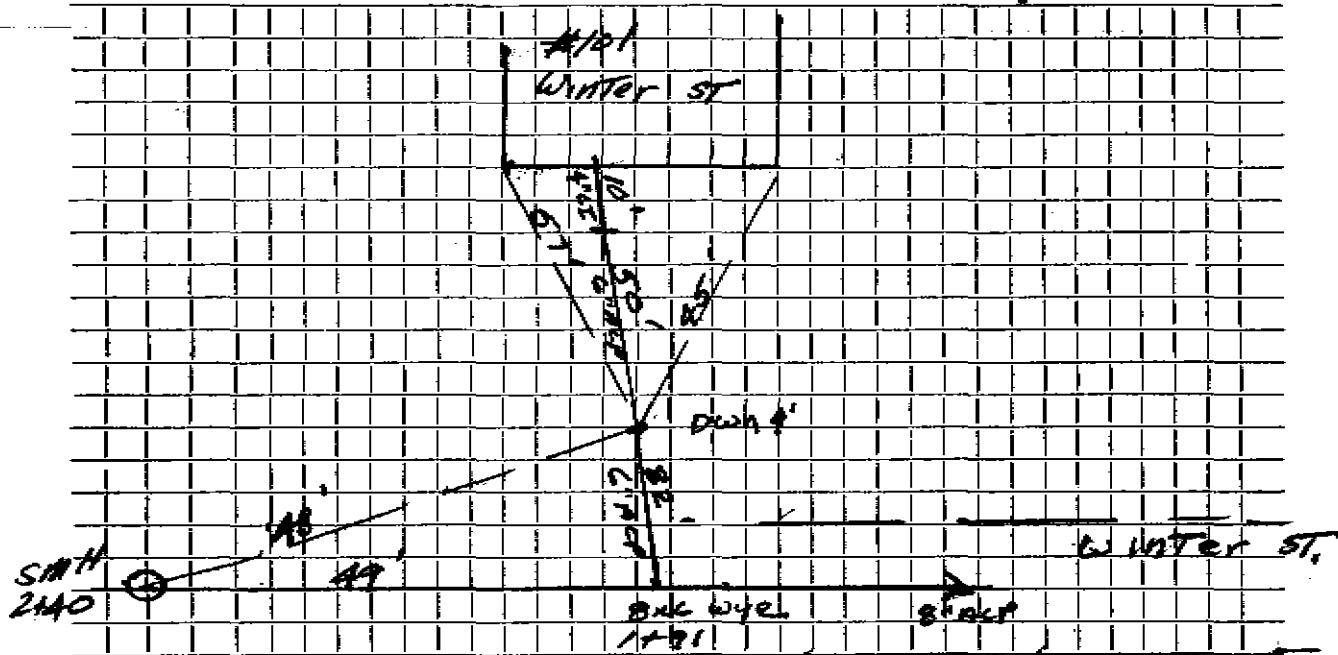

Connection made in Street. Work completed

Remarks:

.....

.....