




DATE 11-30-2001

TOWN OF LEXINGTON — BOARD OF PUBLIC WORKS

SEWER DIVISION

Sketch of Service Here

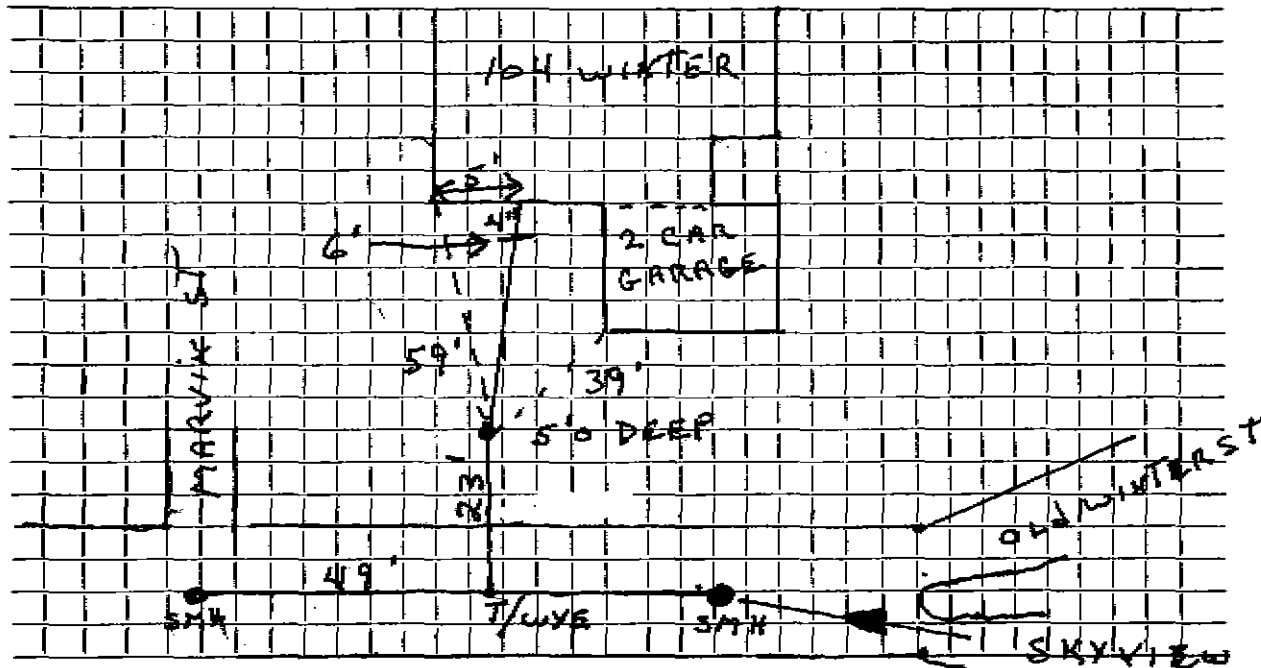

Connection made in WINTER Street. Work completed

Remarks: INSTALLED BY J. MC LAUGHLIN