

Name

Service No.

Address 108 Winter St

108 WINTER STREET

Location

Kind of Pipe AC

Size 6"

Size of Main 8"

Repair—Renewal—New Service


Location

Date		Material	Amount	Total	Date	Amount
7-7-75		1'-6" AC 2	\$10.00	\$10.00		

DATE \_\_\_\_\_

TOWN OF LEXINGTON — BOARD OF PUBLIC WORKS  
SEWER DIVISION

Sketch of Service Here **108**

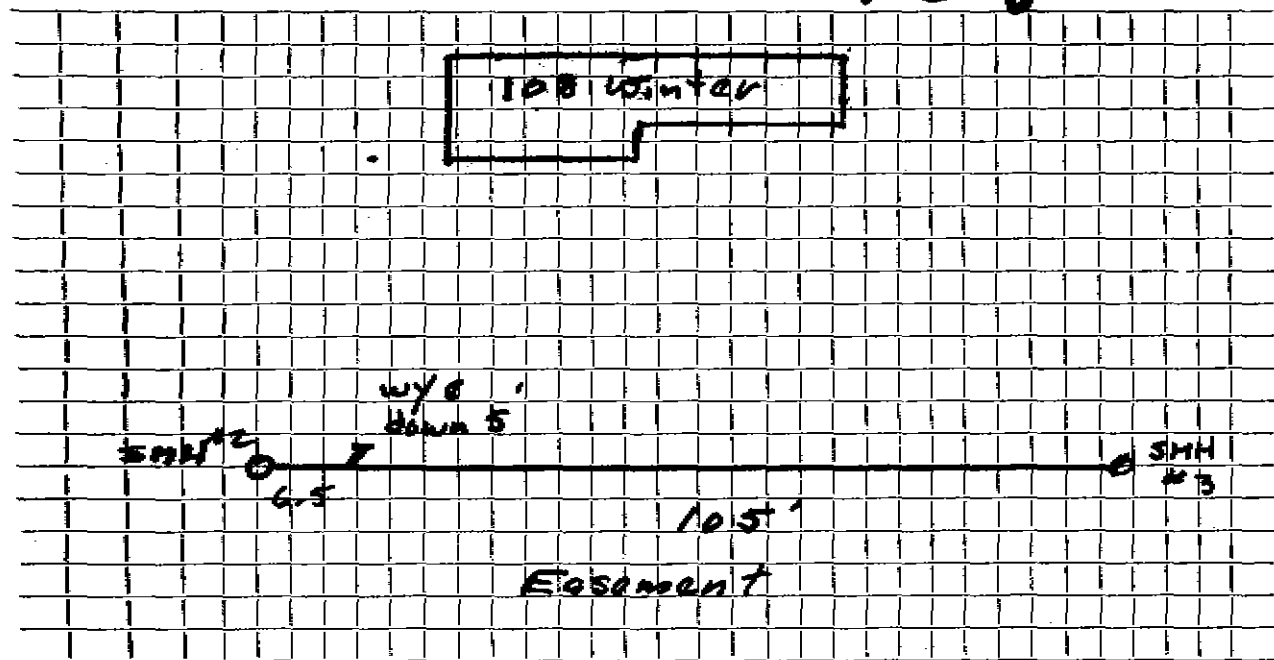

Connection made in Easement Street. Work completed .....

Remarks: .....  
.....  
.....