

Name

Service No.

Address 110 WINTER ST. (VACANT LOT)

110 WINTER STREET

Location

Kind of Pipe A.C.

Size 6"

Size of Main 8"

Repair—Renewal—New Service

Location


Date	Material	Amount	Total	Date	Amount
7/10/73	22'-6" A.C. @ \$8.90	\$ 195.80			

DATE _____

TOWN OF LEXINGTON — BOARD OF PUBLIC WORKS
SEWER DIVISION

Sketch of Service Here

110

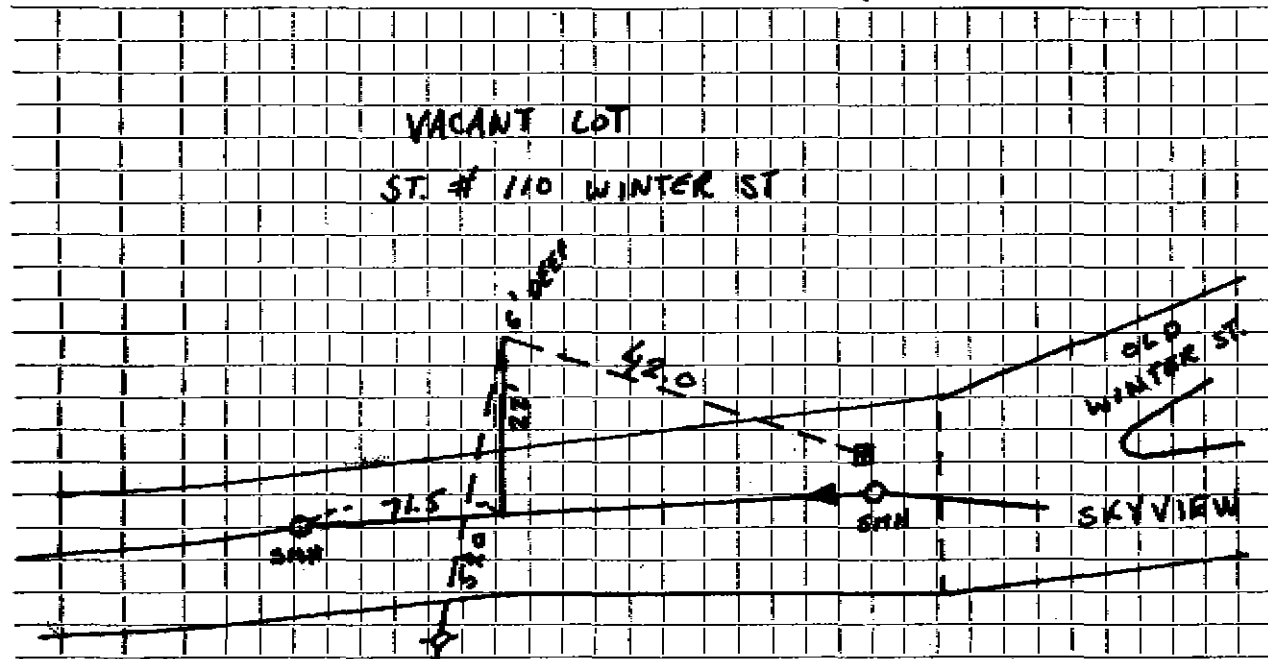

Connection made in _____ Street. Work completed _____

Remarks: _____
