

Name William McGrath

Service No. 107

Address 14 WINTER ST.

14 Winter Street

Location

Kind of Pipe

Size 6"

Size of Main 8"

~~Repair~~ ~~Renewal~~ ~~New Service~~ W 0 # 8140

Location Comm 2-10-64

Date	Material	Amount	Total	Date	Amount
9/10/63	Labor	80 53		8-23-63	Deposit 200 00
	10% O.H.	8 05	88 58	8-4-64	Abate 34 00
	52' 6" Transite Pipe @ .82		42 64	8-4-64	Refund 13 52
	1 90° Transite Elbow		4 09		186 43
	1 6" Adapter		1 62		
	3 Hrs. Town Shovel @ 6.50		19 50		
	2 Hrs. Trucking @ 3.00		6 00		
	Driveway Patch 34 X 3		34 00		
	Street Patch 24.00		24 00		
			220.43		
	Labor				

TOWN OF LEXINGTON—DEPT. OF PUBLIC WORKS
SEWER DIVISION

DATE.....

NO.


The undersigned applies for the construction of a particular sewer connecting No.....
 Street and hereby agrees to comply with the Rules and Regulations governing the construction and use of Particular
 Sewers, as now or at any future time established by the Board of Selectmen.

Am't of estimate \$.....

Am't Paid \$.....

..... Owner

Sketch of Service Here **14**

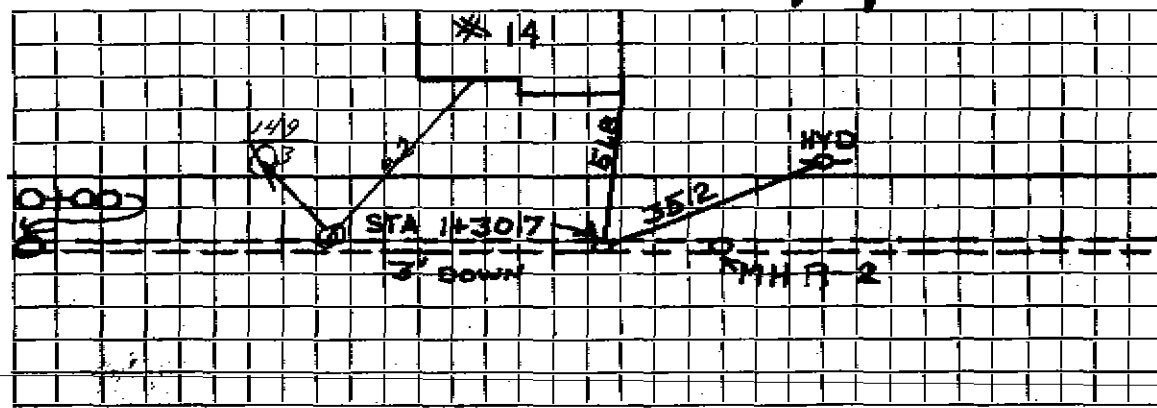

Connection made in Street.

Work completed.....19..

Remarks: