

Name Albert J. Taylor

Service No. 179

Address 30 WINTER ST.

30 Winter Street

Location

Kind of Pipe

Size 6"

Size of Main 8"

Repair—Renewal—New Service

Location Comm 3-16-59

Date	Material	Amount	Total	Date	Amount	
12/1/58	Labor	14 44		11-23-58	Deposit	175 00
12/2/58	"	45 03		3-16-59	Retained	3 29
		59 47				171 71
	10% overhead	5 95	65 42			
	100' - 6" Transite pipe @ .70		70 00			
	1 - 6" Transite Elbor 90°		5 29			
	10x3 Patch		10 00			
	3 hrs. Town Shovel @ 6.50		19 50			
	2 hrs. Trucking @ .75		1 50			
			171 71			
	Labor					

TOWN OF LEXINGTON—DEPT. OF PUBLIC WORKS

SEWER DIVISION

DATE.....

NO.


The undersigned applies for the construction of a particular sewer connecting No.....
Street and hereby agrees to comply with the Rules and Regulations governing the construction and use of Particular
Sewers, as now or at any future time established by the Board of Selectmen.

Am't of estimate \$.....

Am't Paid \$.....

..... Owner

Sketch of Service Here **30**

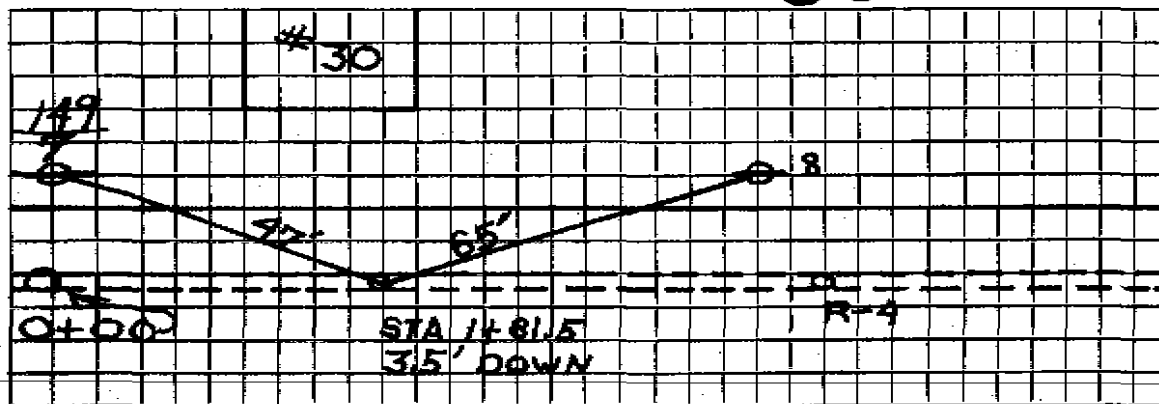

Connection made in..... Street.

Work completed.....19..

Remarks: