

Name Ashita Makherjee

Service No.

Address 40 Winter Street

40 Winter Street

Location

Kind of Pipe

Size 6"

Size of Main 8"

~~Account Name~~ New Service Valeri #4350


Location

Date	Material	Amount	Total	Date	Amount
11/26/86	62' 6" PVC			11/26/86	185.00
	2 22° ELBOWS				
	1 6 x 6 AC to PVC Adapter				
	1 4 x 6 PVC Adapter				
August 1966	21' 6" Transite pipe @ \$5.00		\$105.00		

DATE _____

TOWN OF LEXINGTON — BOARD OF PUBLIC WORKS
SEWER DIVISION

Sketch of Service Here **40**

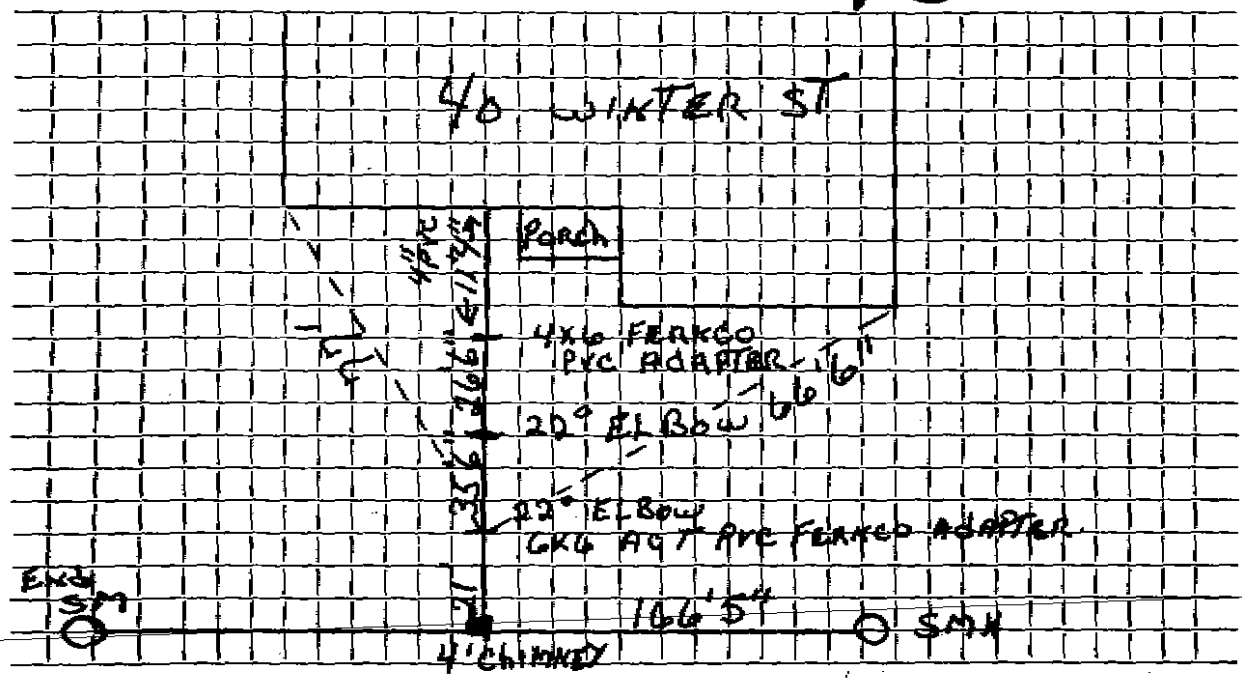

35.6
26.6
11.4
73.6

Connection made in Street. Work completed

Remarks: