

Name

Service No.

Address 43 Winter Street

43 Winter Street

Location

Kind of Pipe

Size 6"

Size of Main 8"

Repair—Renewal—New Service

Location


Date		Material	Amount		Total	Date	Amount	
August	66	27' @ \$5.00	\$135.	00				

DATE _____

TOWN OF LEXINGTON — BOARD OF PUBLIC WORKS

SEWER DIVISION

Sketch of Service Here **43**

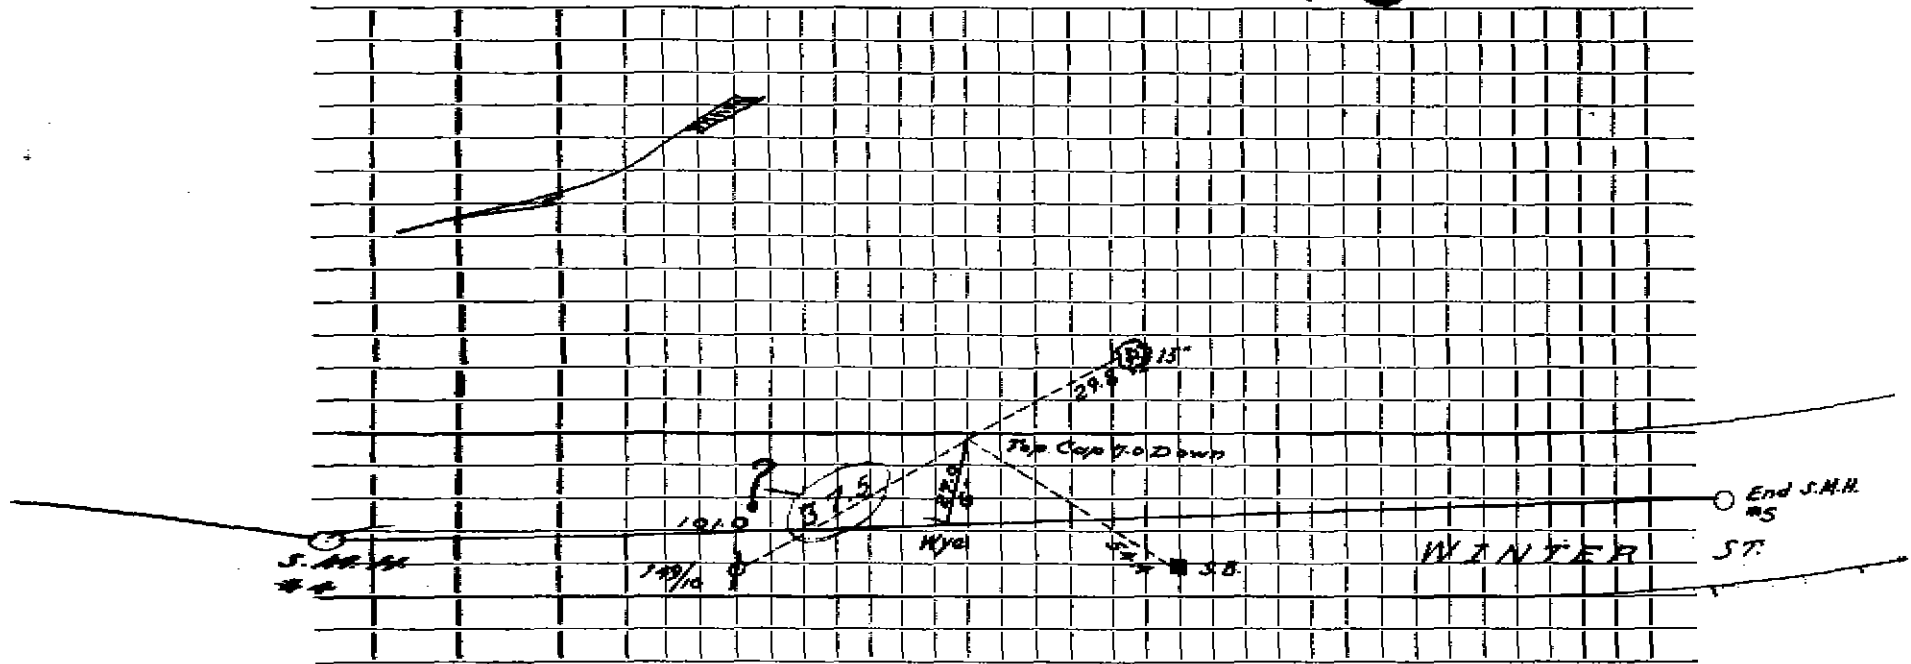

Connection made in Street. Work completed

Remarks :
.....
.....
.....