

Name BOB WHELAN

Service No.

Address 44 WINTER STREET

44 WINTER STREET

Location

Kind of Pipe

Size 6"

Size of Main 8"

Repair

~~Renewal~~

New Service

PERMIT NO. 0933 - SEAN

Location

Date

Material

Amount

Total

Date

Amount

8-66 21'

7-24-70

106 6" Transite Pipe


5 4" Cast Iron

DATE MARCH 20, 1997

TOWN OF LEXINGTON — BOARD OF PUBLIC WORKS
SEWER DIVISION

Sketch of Service Here

44

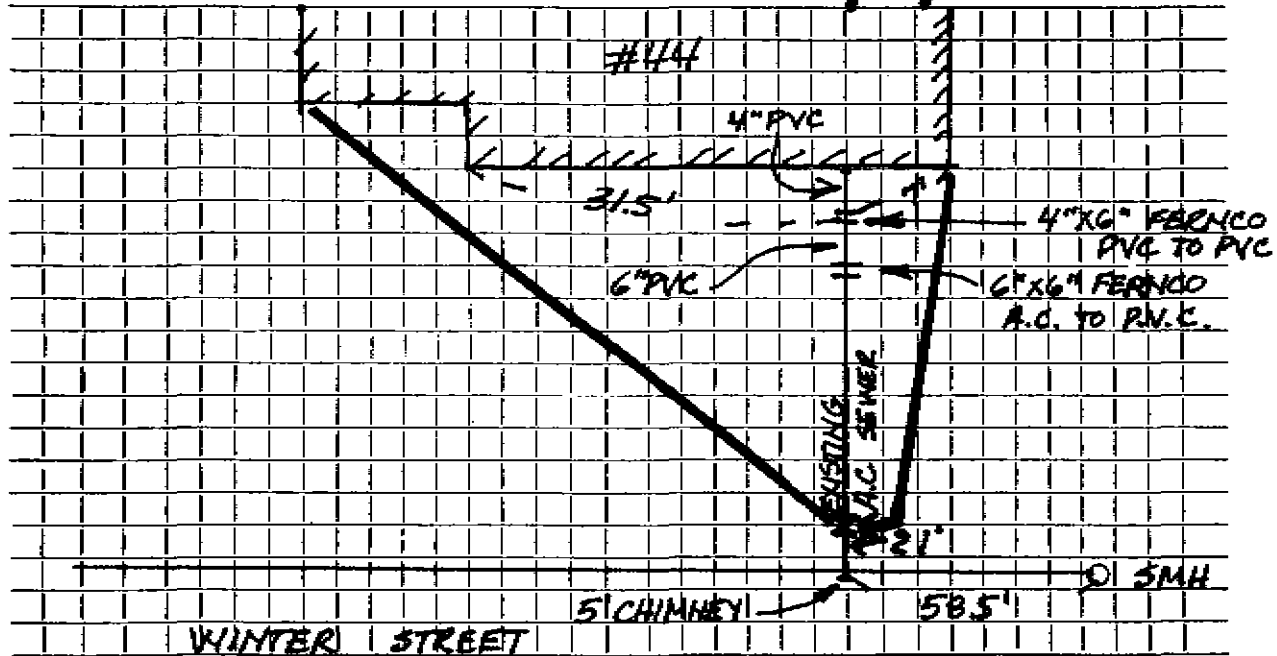

Connection made in ... WINTER STREET Street. Work completed SEAN TOCCI EXCAVATION
Remarks: New house 3-2697, old house Torn down, New house connected To existing...
sewer service.