

Name Arthur O'Sullivan

Service No.

60

Address 48 Winter Street

48 WINTER STREET

Location

Kind of Pipe

Size 6"

Size of Main 8"

Repair—Renewal—New Service

K/1- Smt # 3858

Location OCT 25 1976


Date		Material	Amount		Total	Date	Amount
August	66	23' @ \$5.00	\$115.	00		7-21-74 Deposit error	115.00

DATE _____

TOWN OF LEXINGTON — BOARD OF PUBLIC WORKS
SEWER DIVISION

Sketch of Service Here

48

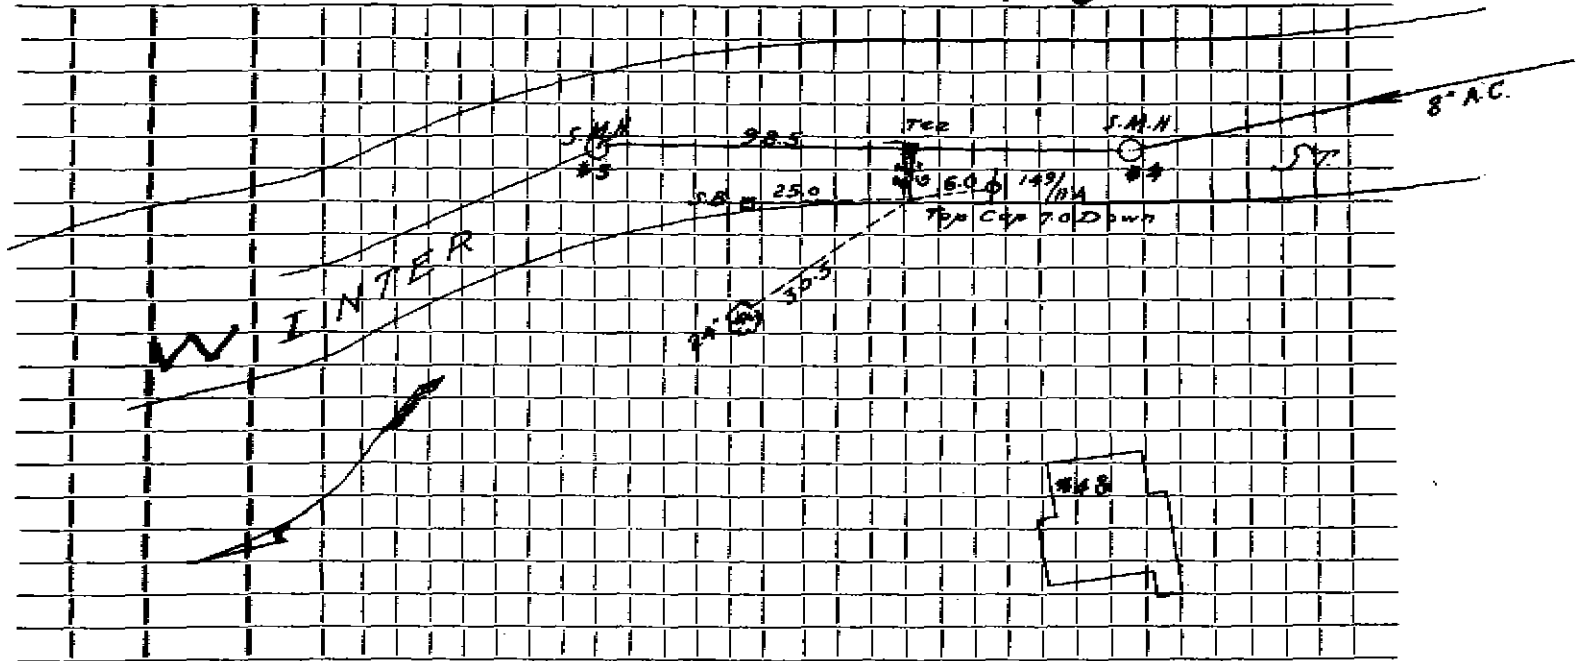

Connection made in _____ Street. Work completed

Remarks:

.....

.....