

Name

Service No.

Address 52 Winter Street

52 Winter Street

Location

Kind of Pipe

Size 6"

Size of Main 8"

Repair—Renewal—New Service

Locations


Date		Material	Amount		Total	Date	Amount	
August	66	21' @ \$5.00	\$105.	00				

DATE _____

TOWN OF LEXINGTON — BOARD OF PUBLIC WORKS

SEWER DIVISION

Sketch of Service Here **52**

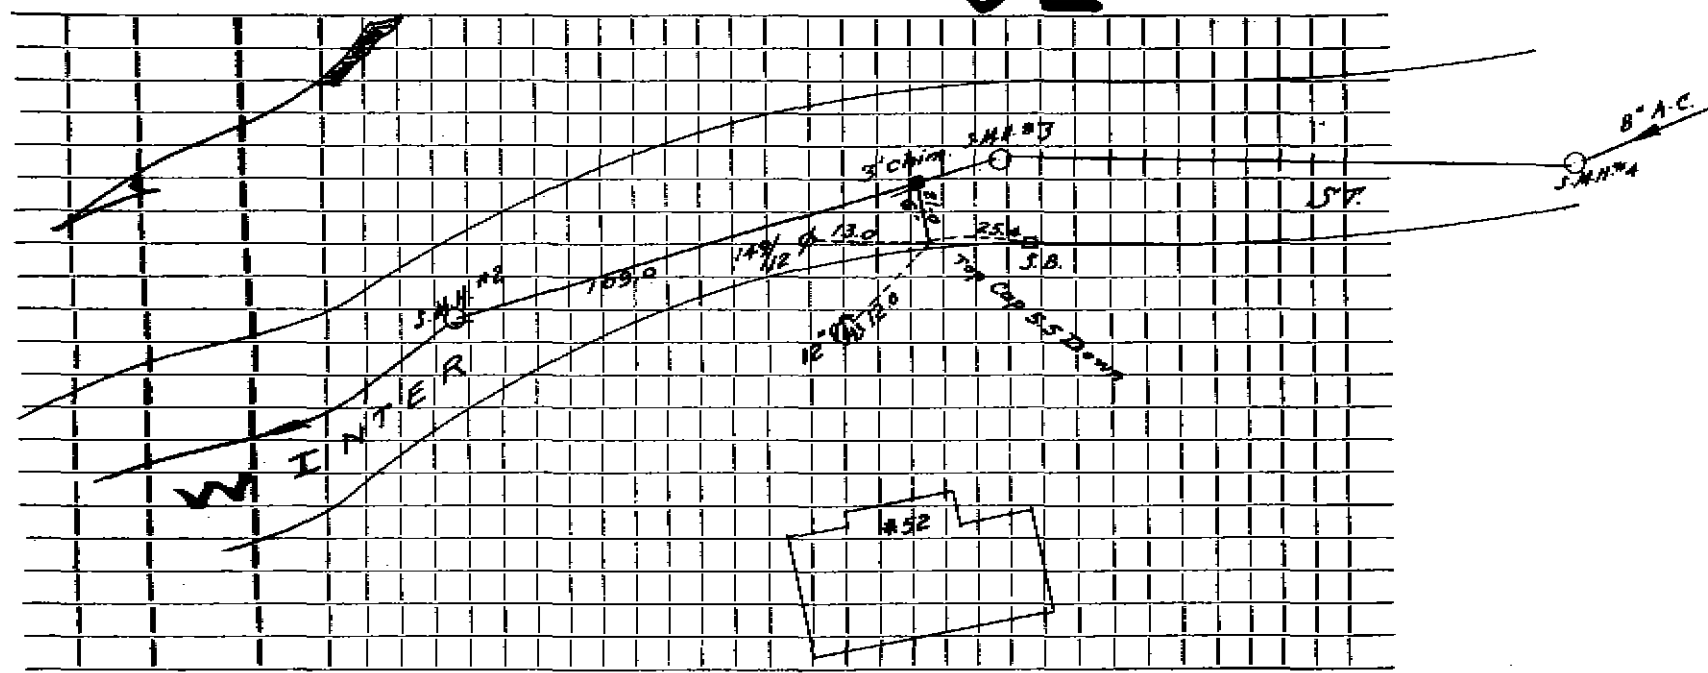

Connection made in Street. Work completed

Remarks :
.....
.....