

Name

Service No.

Address 53 Winter Street

53 WINTER STREET

Location

Kind of Pipe

Size 6"

Size of Main 8"

Repair—Renewal—New Service

Locations

Date	Material	Amount	Total	Date	Amount
August 66	35' @ \$5.00	\$175.00			


DATE _____

TOWN OF LEXINGTON — BOARD OF PUBLIC WORKS

SEWER DIVISION

Sketch of Service Here

53

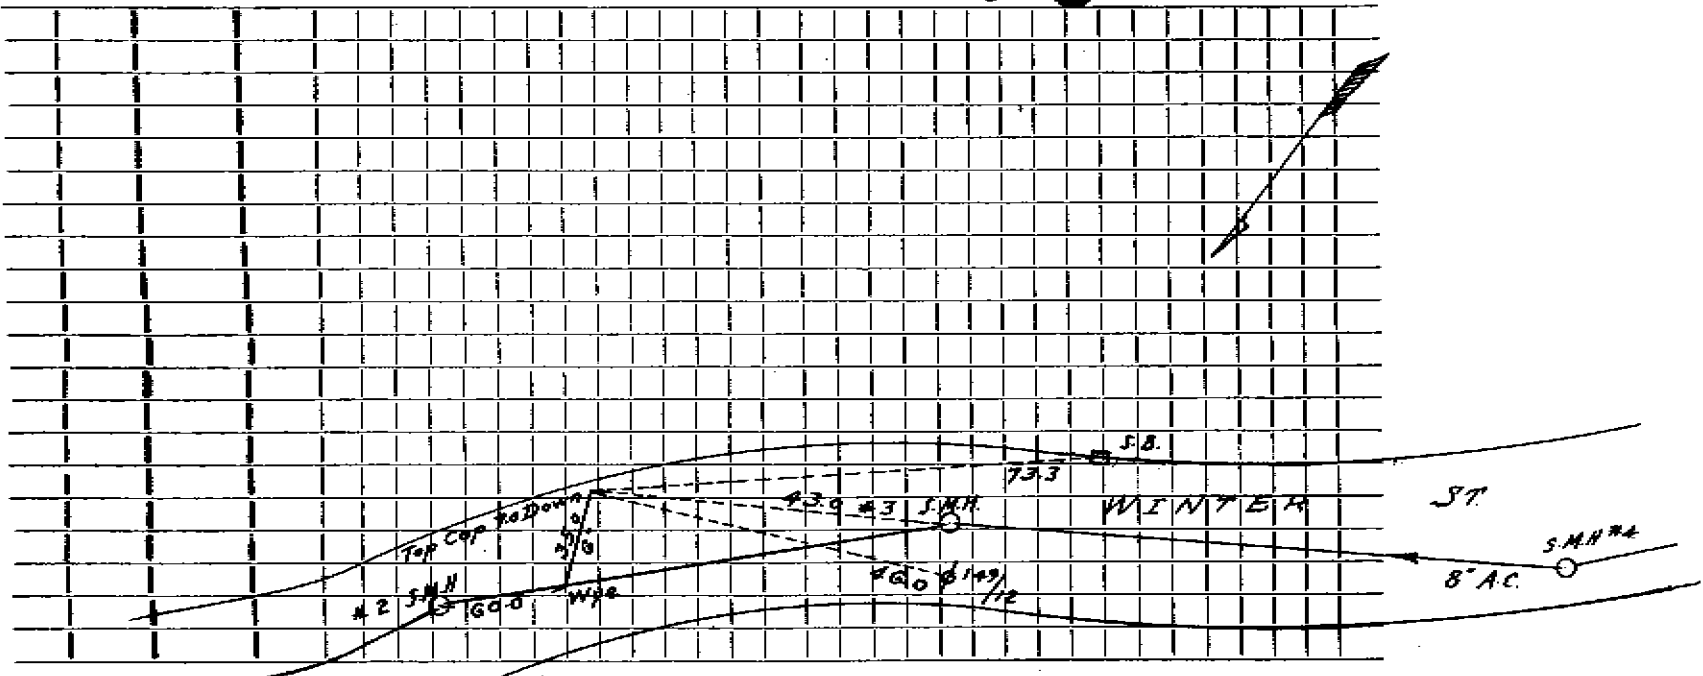

Connection made in Street. Work completed

Remarks:

.....

.....