


DATE _____

TOWN OF LEXINGTON — BOARD OF PUBLIC WORKS

SEWER DIVISION

Sketch of Service Here **60**

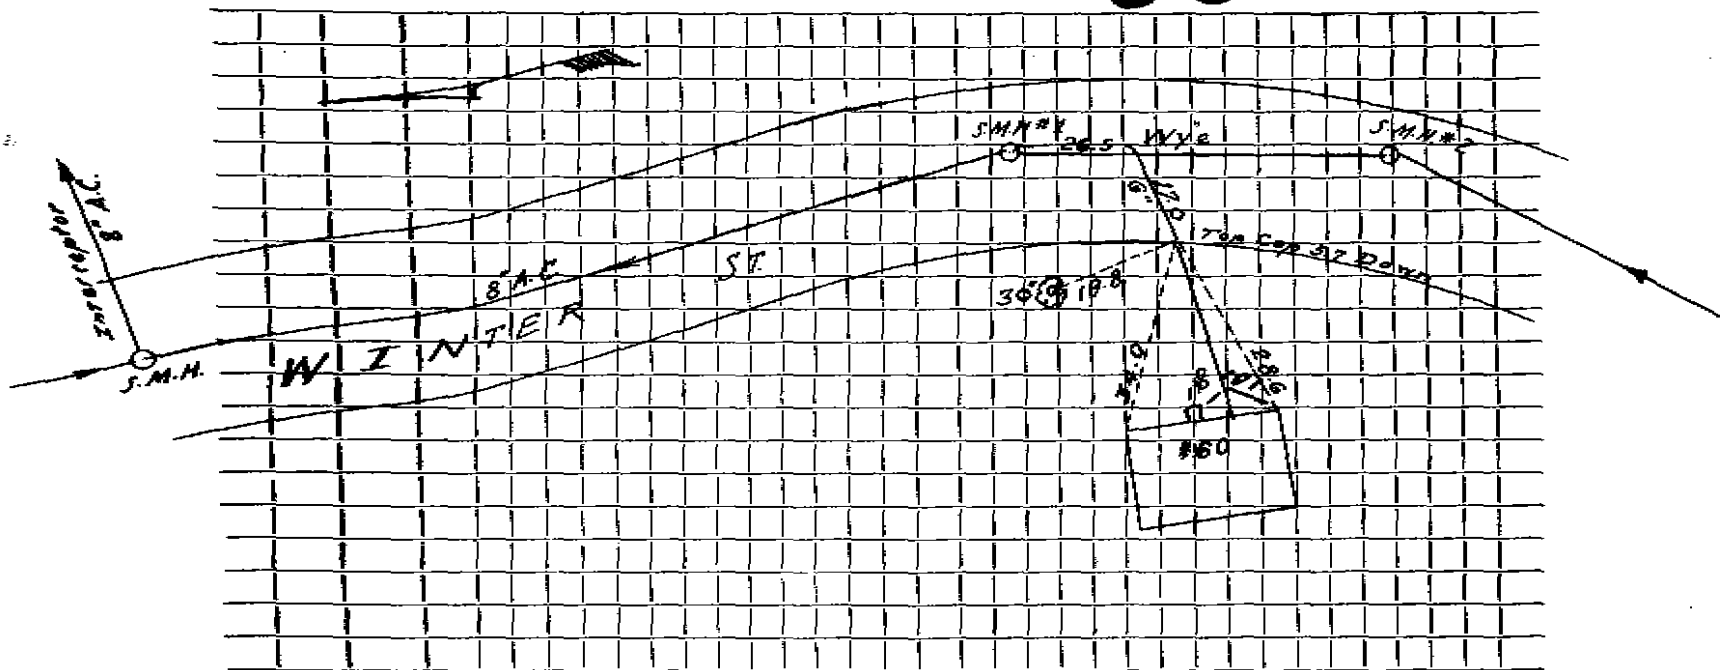

Connection made in Street. Work completed

Remarks: **5' Deep**

.....
.....