

Name

Service No.

Address 68 Winters St

Location

Kind of Pipe

Size

Size of Main

Repair—Renewal—New Service

Location

Date

Material

Amount

Total

Date

Amount

5-24-00

Service excavated inside

78' - 6" PVC

23 - 6" transit outside

10' - 4" PVC

6x4 - Franco

6x6x4 wye cleaned out


6x4 PVC to AC Franco

DATE \_\_\_\_\_

# TOWN OF LEXINGTON — BOARD OF PUBLIC WORKS

## SEWER DIVISION

Sketch of Service Here

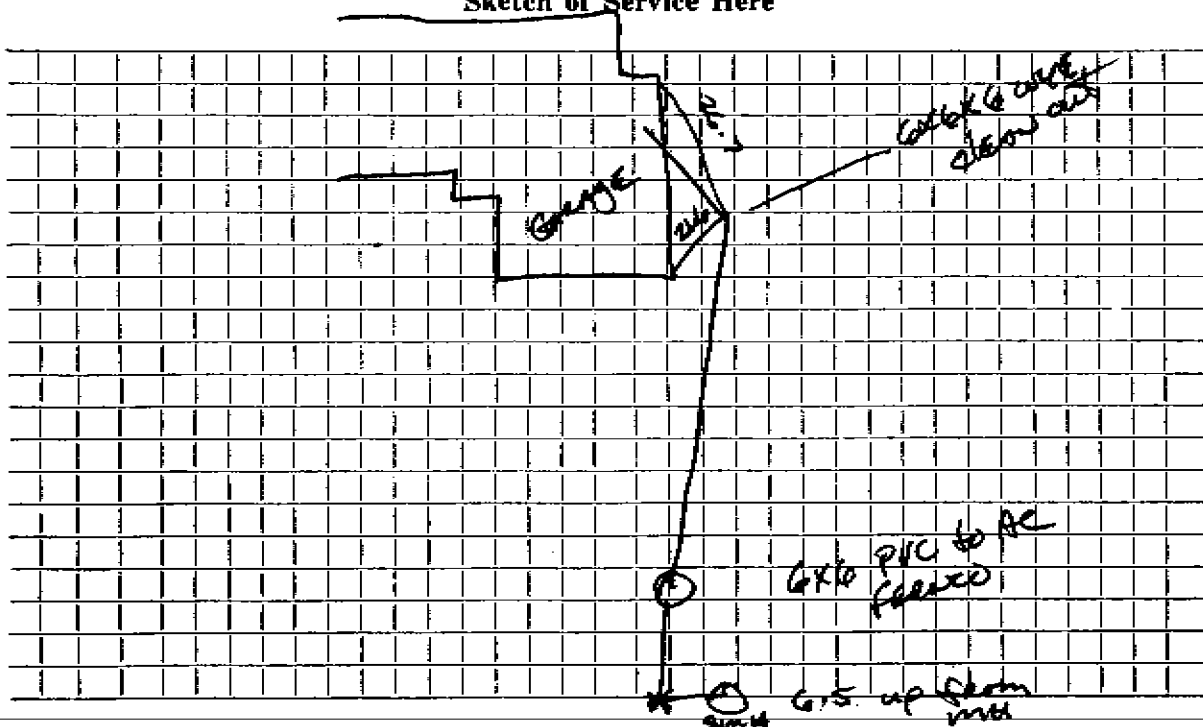

Connection made in ..... Street. Work completed .....

Remarks: .....

.....

.....