

Name Henry Price

Service No. 121

Address 71 Winter Street

71 Winter Street

Location

Kind of Pipe

Size 6"

Size of Main 8"

~~Department~~ New Service

W.O. #2740

Dad's Eagle # 2461

Location FEB 10 1975


Date	Material	Amount	Total	Date	Amount
11-21-74	Labor	68 97		11-15-74	150 00
	10% O.H.	6 90	75 87	4-3-75	31 54
	10' 6" Transite Pipe @1.24		12 40		138 46
	1 6"x8" C.I. Saddle		11 97		Non-Charge WORK
	1 3'x6" Nipple w/coupling		4 80	11-21-74	Labor 22 99
	1 1'x6" Nipple		65		
	1 90° El		5 63		
	1 6" Cap		2 89		
	1 Hr. Trucking	3 00	3 00	7/20/99	Respond + measure (AD)
	1 Hr. Pick-Up	1 50	1 50	10-17-00	Roots 6' from clear-out - Home owners problem
	1 1/2 Hrs. Town Shovel	6 50	9 75		
			\$128 46		
12/10/75	75' 6" Transite Pipe				
	40' 4" Cast Iron Pipe				

DATE

# TOWN OF LEXINGTON — BOARD OF PUBLIC WORKS SEWER DIVISION

Sketch of Service Here

71

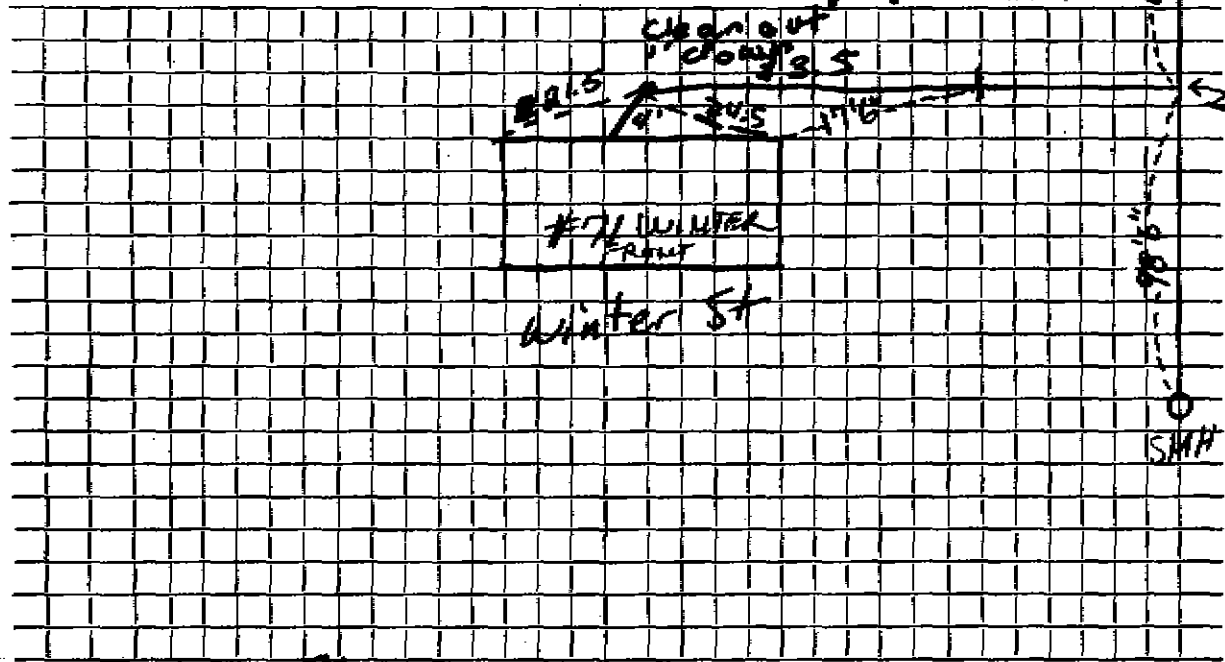

SMH



68'

4" 6" DOWN

4"

98'

4"



SMH

Connection made in winter St. Street.

Work completed 12/10/74

Remarks: Service connected to easement