


DATE _____

TOWN OF LEXINGTON — BOARD OF PUBLIC WORKS SEWER DIVISION

Sketch of Service Here

72

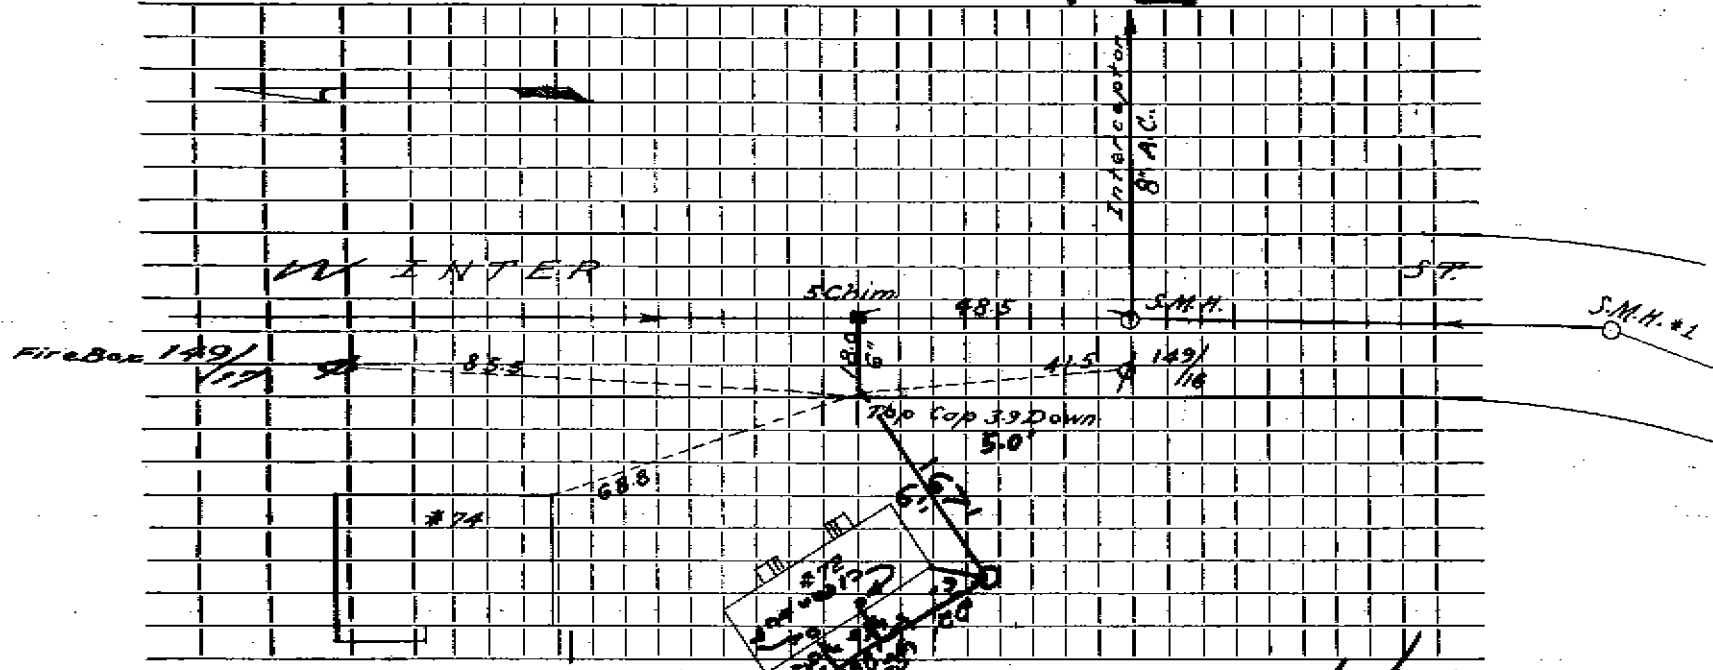

Connection made in 72 Winter St. Street. Work completed 11/19/74

Remarks: