


DATE _____

TOWN OF LEXINGTON — BOARD OF PUBLIC WORKS SEWER DIVISION

Sketch of Service Here **76**

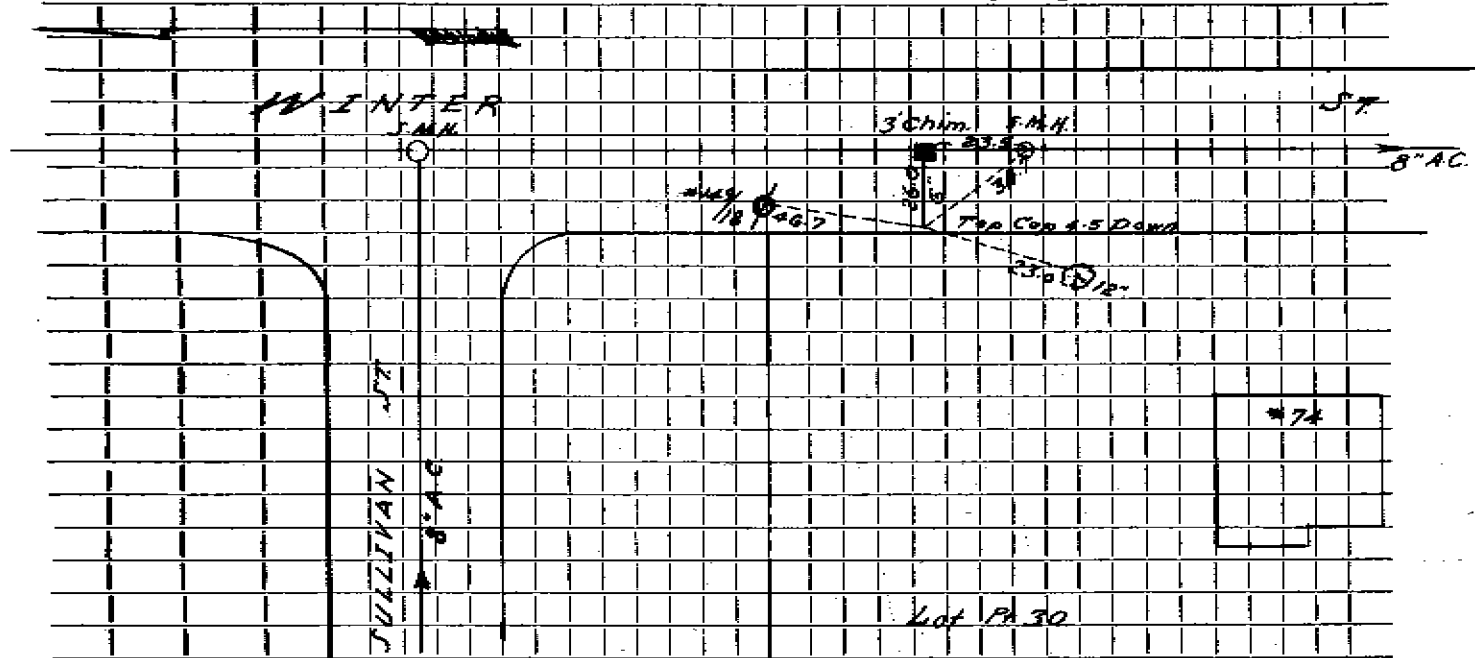

Connection made in _____ Street. Work completed _____

Remarks: _____

