




DATE \_\_\_\_\_

**TOWN OF LEXINGTON — BOARD OF PUBLIC WORKS**  
**SEWER DIVISION**

Sketch of Service Here

**83**

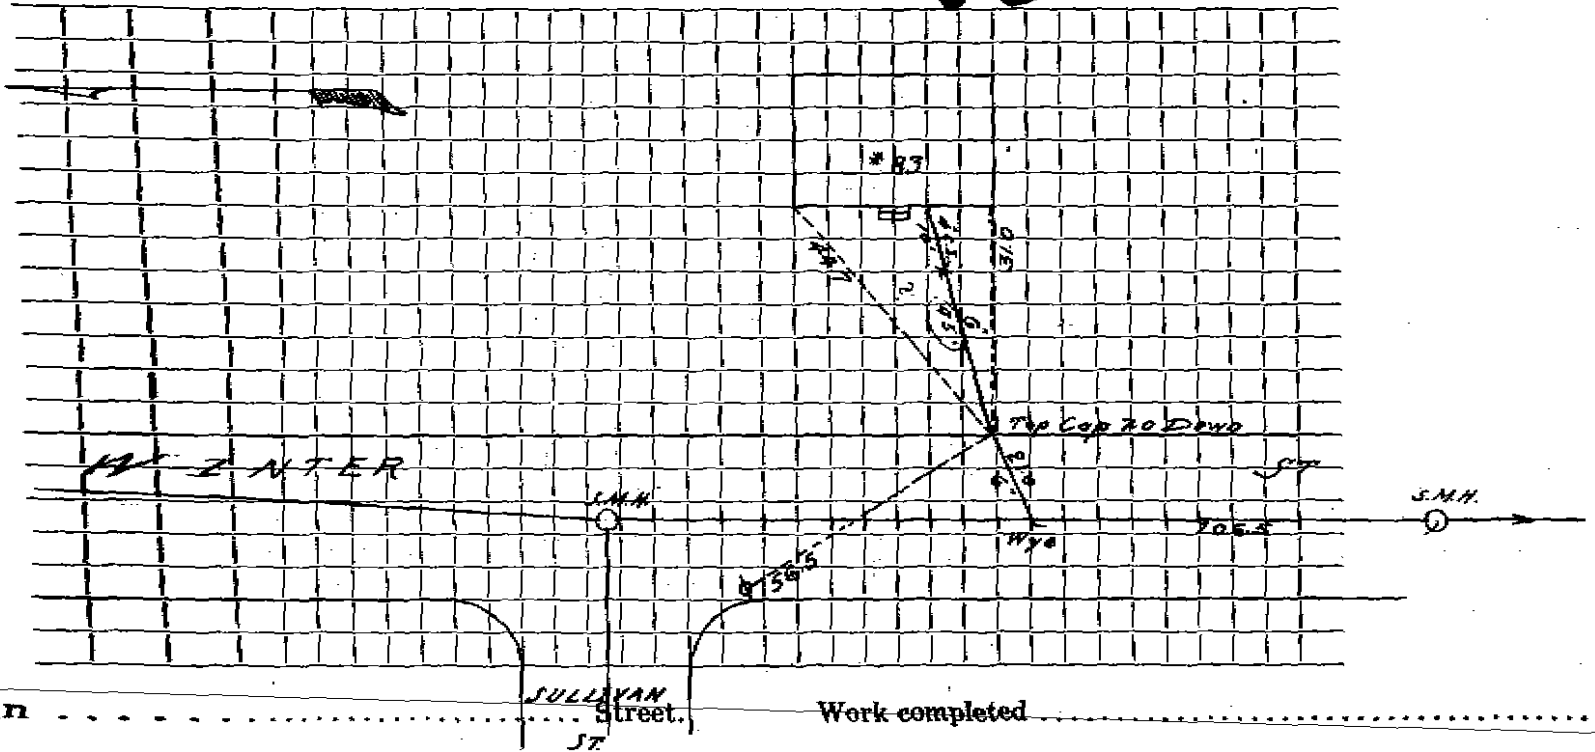

Connection made in ..... Work completed .....

Remarks: .....  
.....  
.....