
Date: 2/21/24

## TOWN OF LEXINGTON - BOARD OF PUBLIC WORKS SEWER DIVISION

SKETCH OF SERVICE HERE 85 Winter St.

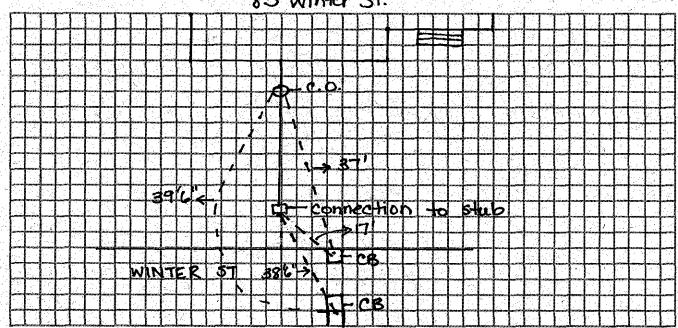

Connection made in:

Street.

Work completed:

Remarks: Installed by J.M. McLaughlin

## **Sewer Service Record**

Name			Service No.			).
Address 8	5 Winter St.					
<del></del>				Location		
Kind of Pipe SDR 35 PVC Repair Renewal - New Service		Size (6"			Size of Main 81	
		•			Location	
Date	Material	Amount	Total	Date		Amount
2/21/24	SDR 35 PVC 6"					
	6" Cleanout					
				•		
	,					
			,			
<u> </u>						+
				<u></u>		