

Name **Edwith Carr**Service No. **145**Address **88 Winter Street****88 Winter Street**

Location

Kind of Pipe

Size **6"**Size of Main **8"**Repair—Renewal—New Service **Lexington Sewerage #957**Location **MAR 18 1968**

Date		Material	Amount		Total	Date		Amount
August	66	24' @ \$5.00	\$120.	00				
10-31-67	45'	6" Transite pipe						
	10'	4" Cast Iron pipe						


DATE \_\_\_\_\_

# TOWN OF LEXINGTON — BOARD OF PUBLIC WORKS

## SEWER DIVISION

Sketch of Service Here

88

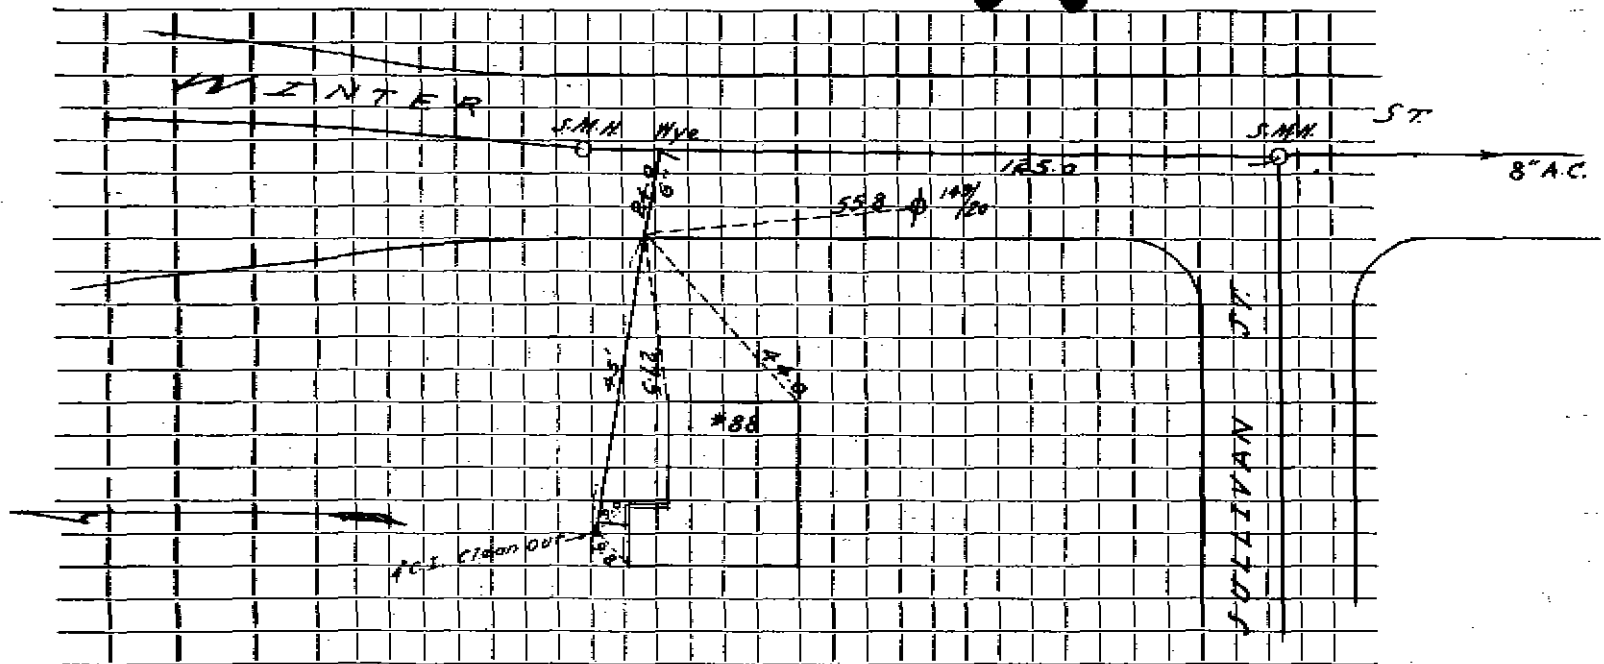

Connection made in \_\_\_\_\_ Street. Work completed \_\_\_\_\_

Remarks: \_\_\_\_\_  
\_\_\_\_\_  
\_\_\_\_\_