


DATE 9 SEPT. 1996

TOWN OF LEXINGTON — BOARD OF PUBLIC WORKS
SEWER DIVISION

Sketch of Service Here

9

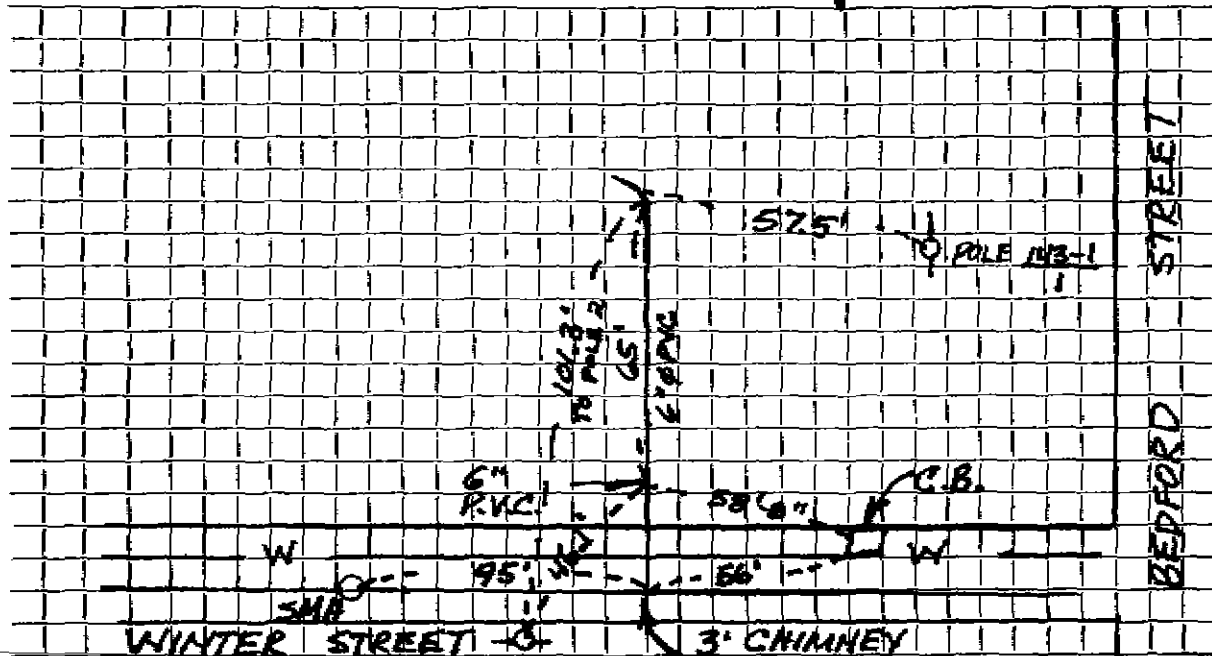

Connection made in WINTER STREET Street. Work completed J.M. MCLAUGHLIN

Remarks: