

Name James F. Casey

Service No. 115

Address 94 Winter Street

Lot #55 94 Winter Street Location Lot 55

Kind of Pipe

Size 6"

Size of Main 8"

Repair—Renewal—New Service Suburbanite #1489

Location MAR 3 11 10 79


Date	Material	Amount	Total	Date	Amount
10-1-69	47' 6" Transite pipe @9.00		423.00	10-14-69	Deposit 423.00
10-21-69	26' 6" Transite pipe				
	14' 4" Cast Iron pipe				

DATE \_\_\_\_\_

TOWN OF LEXINGTON — BOARD OF PUBLIC WORKS

SEWER DIVISION

Sketch of Service Here **94**

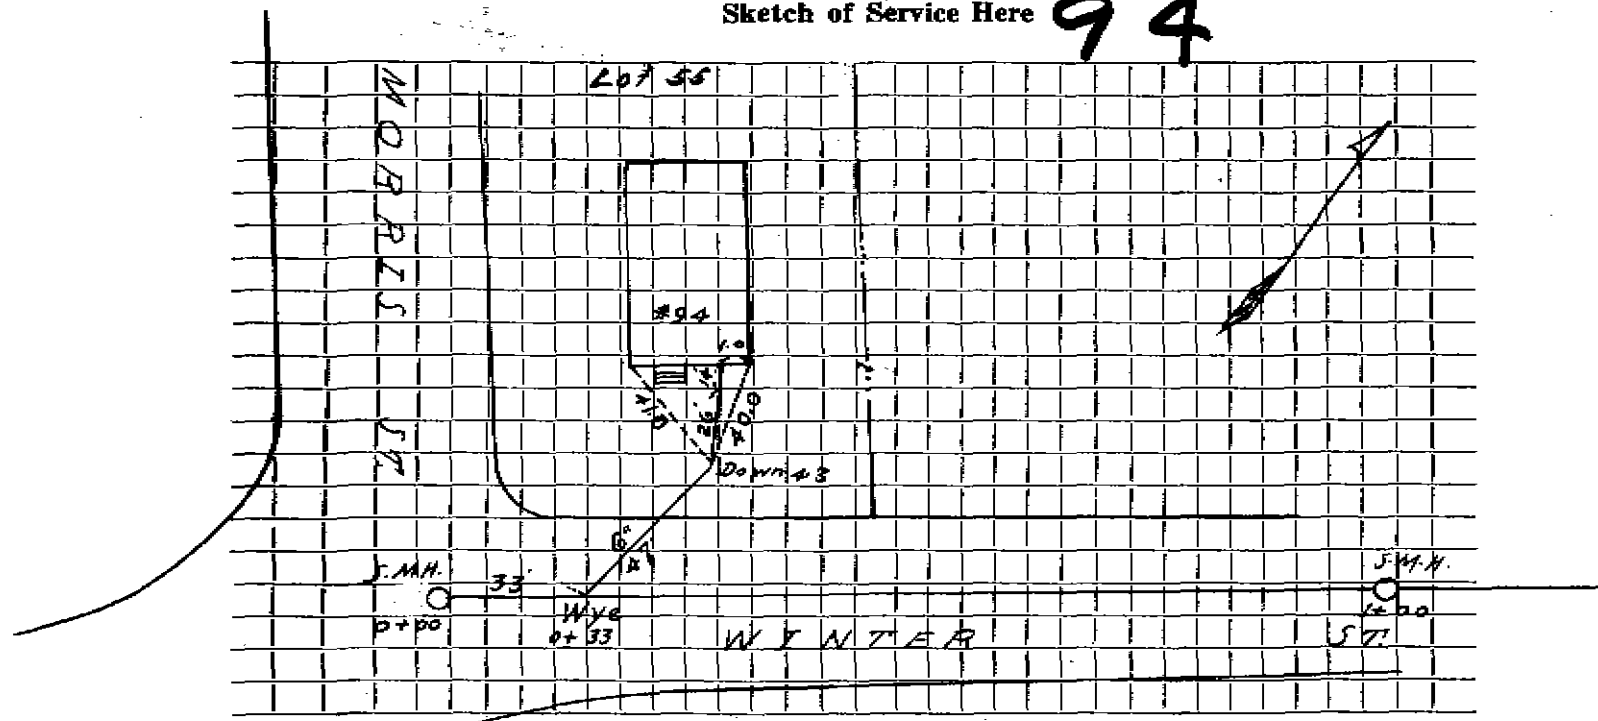

Connection made in ..... Street. Work completed .....

Remarks: .....  
.....  
.....