

Name

Service No.

569

Address

10 Winthrop Rd

10 Winthrop Road

Location

10 Winthrop Road

Kind of Pipe

Size 6"

Size of Main 8"

Repair—Renewal—New Service

Location

1927

Date

Material

Amount

Total

Date

Location

Amount

Labor

TOWN OF LEXINGTON—BOARD OF PUBLIC WORKS  
SEWER DIVISION

DATE \_\_\_\_\_

NO. \_\_\_\_\_


The undersigned applies for the construction of a particular sewer connecting No. 10 Winthrop Rd.  
Street and hereby agrees to comply with the Rules and Regulations governing the construction and use of Particular  
Sewers, as now or at any future time established by the Board of Selectmen.

Am't. of Estimate \$ \_\_\_\_\_

Am't. Paid \$ \_\_\_\_\_

Owner \_\_\_\_\_

Sketch of Service Here 10

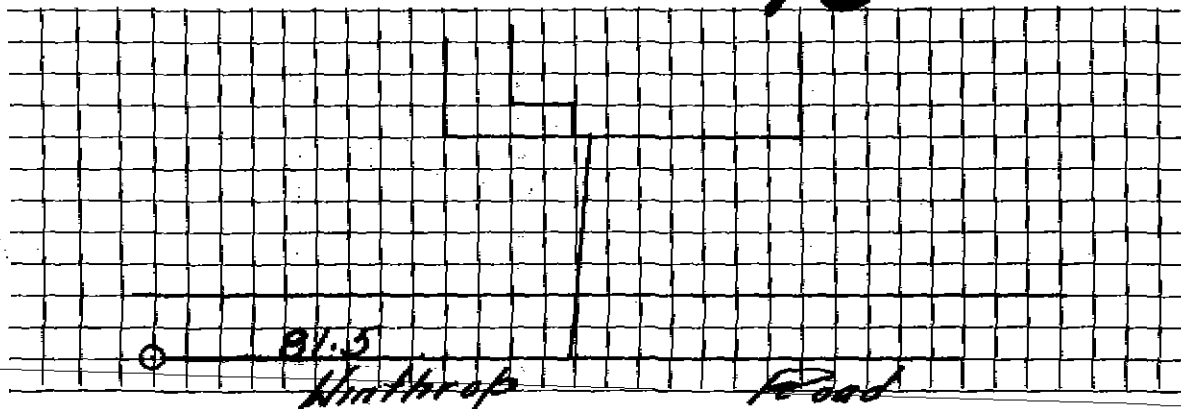

Connection made in \_\_\_\_\_ Street.

Work completed \_\_\_\_\_ 19

Remarks: