




DATE 6/14/88

# TOWN OF LEXINGTON — BOARD OF PUBLIC WORKS SEWER DIVISION

Sketch of Service Here

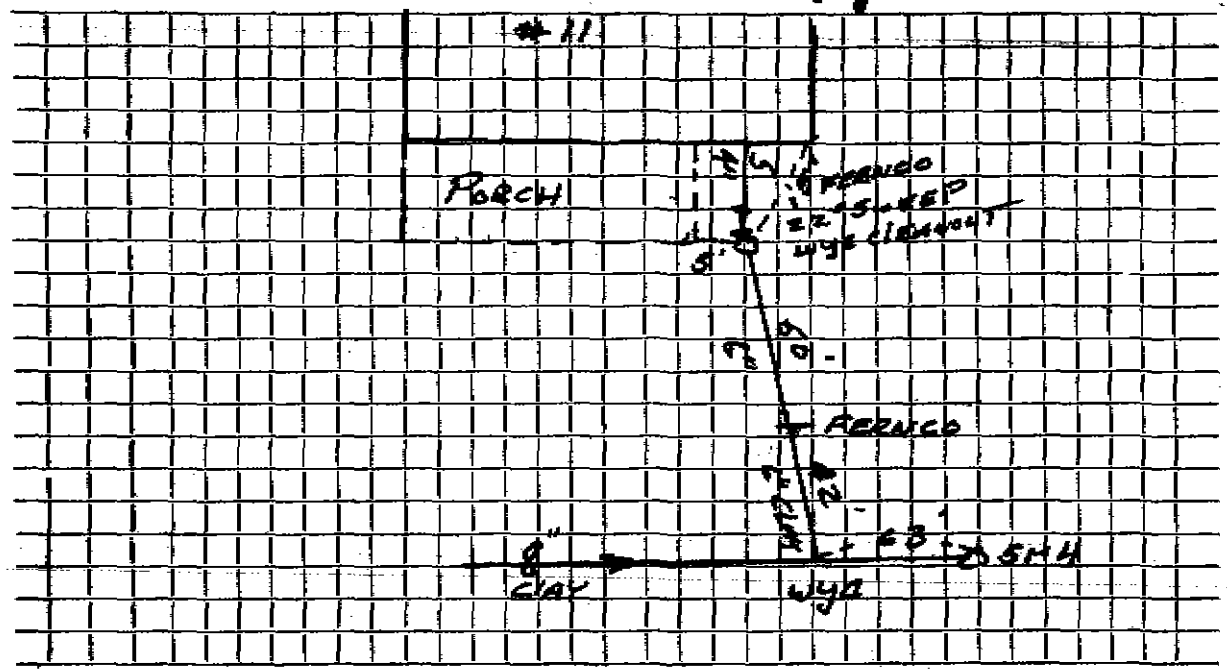

Connection made in WINTHROP Street. Work completed

Remarks: Original service... 1927. (Sidewalk To main 6" clay, looks O.K. 6-8-88.

J.M.W.)