

Name Dr. Edward Palmer - AGGUIREService No. 103Address 17 Winthrop Road17 Winthrop Road

Location

Kind of Pipe

Size 6"Size of Main 8"~~Repair~~ New ServiceCOM. 9-6-55PERMIT NO. 0982
SEAN TOCCI

Location

Date	Material	Amount	Total	Date	Amount
7/12/55	Labor	50 50		6-1-55	200 00
7/13/55	"	40 15	90 65	9-6-55	3 09
	10% overhead		9 06		196 91
	74' - 6" sewer pipe @ .32		23 68		
	joint compound		2 52		
	2 hrs. trucking @ .75		1 50		
	patching 32 x 3		32 00		
	5 hrs. Littlefield shovel @ 7.50		37 50		
			196 91		
	Ledge:				
	Of the 74' of 6" sewer pipe, 32' was 6" cast iron pipe				
	Labor				
7/9/1997	32' - 6" ϕ PVC				
	1.5 - 4" ϕ PVC				
	1 - 6" X 6" FERNCO				
	1 - 4" X 6" FERNCO				

TOWN OF LEXINGTON—DEPT. OF PUBLIC WORKS

SEWER DIVISION

DATE JULY 9, 1997.....

NO.


The undersigned applies for the construction of a particular sewer connecting No.
Street and hereby agrees to comply with the Rules and Regulations governing the construction and use of Particular
Sewers, as now or at any future time established by the Board of Selectmen.

Am't of estimate \$.....

Am't Paid \$.....

..... Owner

Sketch of Service Here

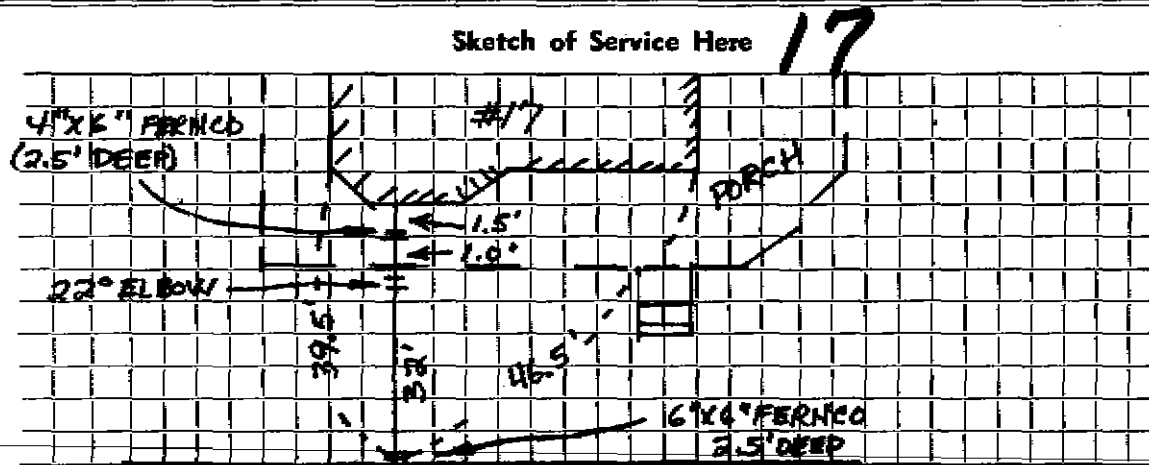

Connection made in Street. Work completed 19..

Remarks:

WINTHROP

ROAD